

SMITH

MISSISSIPPI BOARD OF WATER COMMISSIONERS

E 28

2-7-61

WATER WELL DRILLERS LOG

E - 303

Date: Feb. 7, 1961, Driller: W.G. Butler County Smith

(Name)

(1) Owner of Land: Earl Smith

(Name)

POAKVILLE MISSISSIPPI

(Address)

38 Acres NE 1/4 NE 1/4, Sec. 1 T31N R16E

(2) Location: NE 1/4 NE 1/4, Sec. 1 T31N R16E

12 miles NW of Raleigh

(distance)

(direction)

(Nearest Town)

(3) Topography:  (Level)

(Hilly)

(Flat)

(Level)

(4) Purpose of Well: Domestic

(Domestic Irrigation, Municipal, Industrial, Other)

Information upon completion of well:

(1) Diameter 2 inches.

(2) Total Depth 115 feet.

(3) Water Level 60 feet below top of ground.

(4) Cased to 105 feet, Size 2 inches

(5) Screen: Size 2 inches, Length 10 feet

(6) Were any formations sealed against pollution?

yes,  no.

If YES depth of formation

Why

Drillers Remarks:

Description & Color of Materials  
Sand, Clay, Red Clay, Shell, etc.

Thick-  
ness  
Feet

Depth  
Feet

Red Clay

1 to 4

Chalk

4 to 10

Green Chalk

10 to 20

"

20 to 50

Rock

50 to 60

Chalk

60 to 65

Rock

65 to 75

Chalk

75 to 80

Rock

80 to 95

Chalk

95 to 100


Sand + shell

100 to 110

Sand

110 to 115

E 1

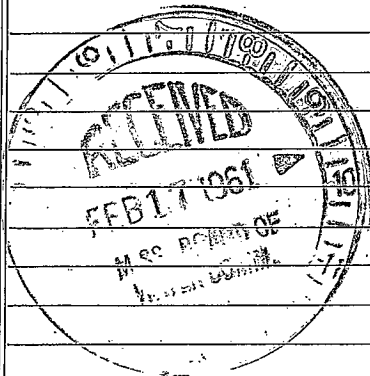

(Use Back Side)

Well No.

