

SMITH MISSISSIPPI BOARD OF WATER COMMISSIONERS


6 E 30
1-12-62

ET

WATER WELL DRILLERS LOG

Date: Jan 12, 1962, Driller: W. H. Butler County Smith
(Name)

(1) Owner of Land:	Description & Color of Materials Sand, Clay, Red Clay, Shell, etc.	Thick- ness Feet	Depth Feet
<u>J. A. Derrick</u> (Name) <u>Ma gee</u> , <u>Miss. Rts</u> (Address)	<u>Top Soil</u>	<u>0</u>	<u>1</u>
(2) Location: <u>1/4</u> , <u>1/4</u> , Sec. <u>28</u> T.3R.6	<u>Chalk</u>	<u>1-10</u>	
<u>12</u> miles <u>West</u> , of <u>Raleigh</u> (distance) (direction) (Nearest Town)	<u>Sand + Chalk</u>	<u>10-20</u>	
(3) Topography: <input checked="" type="checkbox"/> (Level)	<u>Sand</u>	<u>20</u>	<u>28</u>
(4) Purpose of Well: <u>Domestic</u> (Domestic Irrigation Municipal, Industrial, Other)			
Information upon completion of well:			
(1) Diameter <u>2"</u> inches.			
(2) Total Depth <u>28</u> feet.			
(3) Water Level _____ feet below top of ground.			
(4) Cased to <u>21</u> , Size <u>2"</u>			
(5) Screen: Size <u>2"</u> , Length <u>6</u>			
(6) Were any formations sealed against pollution? _____ yes, _____ no.			
If YES depth of formation _____			
Why _____			
Drillers Remarks:			

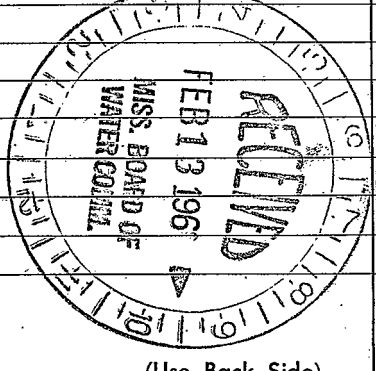

(Use Back Side)

Well No.

