

SMITH  
E 3  
3-68

MISSISSIPPI  
BOARD OF WATER COMMISSIONERS  
416 North State Street  
Jackson, Mississippi 39201

WATER WELL DRILLERS LOG

Mar. 9 1968 W. G. Butler Smith  
date well completed firm name county well located

LANDOWNER: D. E. Dukas

description of formations encountered

from to

Red clay + Red sand	0	10
Sand & chalk	10	20
Sand	20	60
good sand	60	87

Magee, Miss Rt 3 -  
(mailing address)

WELL LOCATION:

sec 34 T 3 N R 6 E  
S W

miles of  
(distance) (direction) (nearest town)

WELL PURPOSE: Home  
(home, irrigation, municipal, industrial)

WELL COMPLETION DATA:

(1) diameter (inches) 2"  
(2) total depth (feet) 87  
(3) static water level (feet) \_\_\_\_\_ below above top of ground.

(4) casing 2" 75'  
(material) (depth)

2" If telescope see back.  
(size)

(5) screen 10' 75'  
(length) (depth to top)

2" S. Steel  
(size) (material)


(6) pump \_\_\_\_\_ (HP) \_\_\_\_\_ (yield gpm)

Electric  
(type power)

(7) electric log No  
(yes or no)

(organization running log)


(8) how well bottom plugged 2" B.W.I.

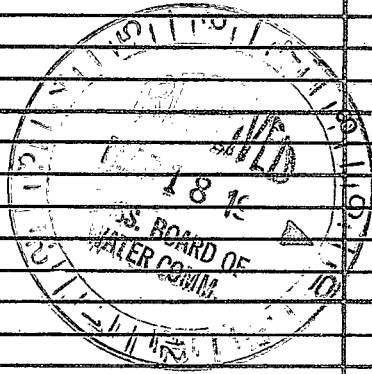

DRILLERS REMARKS:

If well telescopes please sketch and show depths.

GROUND LEVEL

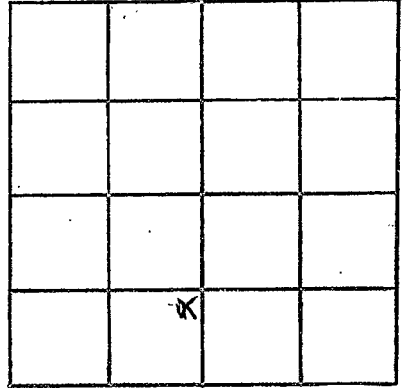

SECTION 34

Please indicate well location X.

ADDITIONAL INFORMATION

If more than one screen, show locations of each on sketch.