

**MISSISSIPPI  
BOARD OF WATER COMMISSIONERS**  
416 North State Street  
Jackson, Mississippi 39201

**WATER WELL DRILLERS LOG**

SMITH  
E 32  
2-68

Feb. 23 - 1968 date well completed      W. H. Butler firm name      Smith county well located

**LANDOWNER:**  
Alfred Yates  
Morton, Miss. Rt 4  
(mailing address)

description of formations encountered	from	to
SAND & Chalk	0	40
Blue Chalk	40	90
Blue Chalk + Shell	90	120
Rock + Shell	120	130
Rock + Chalk	130	150
Chalk	150	160
SAND, Shell, lignite	160	183
Chalk + lignite	183	223
SAND + Chalk	223	233
Chalk	233	243
SAND	243	253
SAND + Chalk	253	263

**WELL LOCATION:**  
sec. 10 T. 30 N. R. 6 E.  
S. W.

(distance) \_\_\_\_\_ miles of \_\_\_\_\_ (direction) \_\_\_\_\_ (nearest town)

**WELL PURPOSE:** Home -  
(home, irrigation, municipal, industrial)

**WELL COMPLETION DATA:**

(1) diameter (inches) 2"

(2) total depth (feet) 263

(3) static water level (feet) \_\_\_\_\_ below/above top of ground.


(4) casing galv. (material), 243 (depth)  
2" (size) if telescope see back.

(5) screen 10' (length), 243' (depth to top)  
2" (size), Stainless Steel (material)

(6) pump 1 (HP), \_\_\_\_\_ (yield gpm)  
Electric (type power)

(7) electric log NO (yes or no)  
\_\_\_\_\_  
(organization running log)


(8) how well bottom plugged 2" B.W.V.

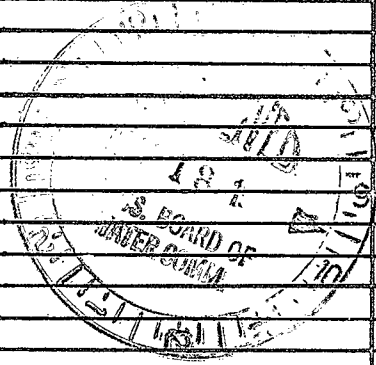

**DRILLERS REMARKS:** \_\_\_\_\_

If well telescopes please sketch and show depths.

GROUND LEVEL

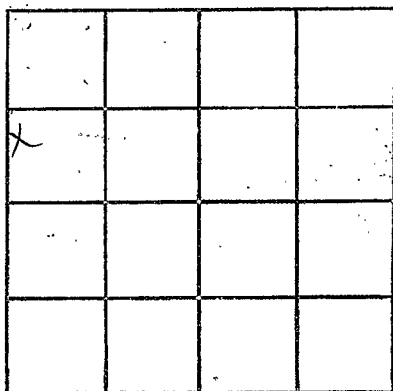

SECTION \_\_\_\_\_

Please indicate well location X.

ADDITIONAL INFORMATION

If more than one screen, show locations of each on sketch.