

MISSISSIPPI  
BOARD OF WATER COMMISSIONERS  
416 North State Street  
Jackson, Mississippi 39201

**CODED**

WATER WELL DRILLERS LOG

SMITH  
E36  
11-2-70

Nov. 2 1970 W. G. Bullen Smith Co  
date well completed firm name county well located

LANDOWNER: Mrs. Lucy Hughes  
Palsville, Miss.  
Rt. 1  
(mailing address)

description of formations encountered	from	to
Clay - Rock - Sand	0	20
Sand - Clay	20	20
Clay - Rock	40	50
Rock - Clay - Sand	50	60
Sand	60	68

WELL LOCATION:  
sec. 12-T 3 N R 6 E  
S W  
2 1/2 miles NE of Whitman  
(distance) (direction) (nearest town)

WELL PURPOSE:  
(home, irrigation, municipal, industrial)

- WELL COMPLETION DATA:
- (1) diameter (inches) 2"
  - (2) total depth (feet) 68'
  - (3) static water level (feet) \_\_\_\_\_ below above top of ground.
  - (4) casing galv., 63',  
(material) (depth)  
2"  
(size) if telescope see back.
  - (5) screen 5', 63'  
(length) (depth to top)  
2", SS,  
(size) (material)
  - (6) pump \_\_\_\_\_ (HP) \_\_\_\_\_ (yield gpm)  
Electric  
(type power)
  - (7) electric log NO  
(yes or no)
  - (organization running log)
  - (8) how well bottom plugged 2" BWV

**CODED**


DEC 7 1970

DRILLERS REMARKS:

MISS. BD. OF  
WATER COMM

If well telescopes please sketch and show depths.

GROUND LEVEL

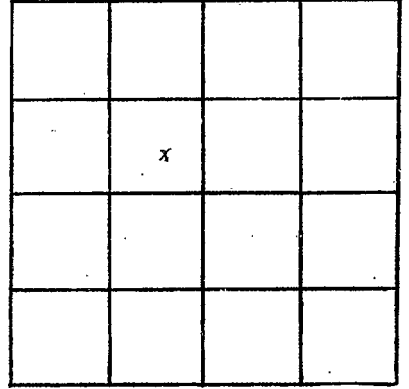

SECTION 101

Please indicate well location X.

ADDITIONAL INFORMATION

If more than one screen,  
show locations of each on sketch.