

SMITH  
E 38  
6-30-71

MISSISSIPPI  
BOARD OF WATER COMMISSIONERS  
416 North State Street  
Jackson, Mississippi 39201

**CODED**

WATER WELL DRILLERS LOG

June 30 1971 W. G. Butler Smith  
date well completed firm name county well located

LANDOWNER:  
Torie Banyard  
Annie Hughes  
Morton, Miss.  
(mailing address) RT 4

description of formations encountered	from	to
Clay	0	10
Rock & clay	20	30
Sand & clay	30	50
Clay	50	55
Clay & Sand	55	70
Clay	70	115
Shell Sand	115	120
Clay	120	155
Rock	155	160
Rock & Shell	160	20
Rock	170	190
Sand Shell, Clay	190	212
Lignite & clay	212	232
Sand	232	253
Clay	253	263
Sand	253	266
Clay	266	276
Sand & Clay	276	316

WELL LOCATION:  
sec. 13 T. 3 N. R. 6 E.  
3 miles N. of White Oak  
(distance) (direction) (nearest town)

WELL PURPOSE: Hand  
(home, irrigation, municipal, industrial)

- WELL COMPLETION DATA:
- (1) diameter (inches) 2"
  - (2) total depth (feet) 316
  - (3) static water level (feet) 104 below top of ground.
  - (4) casing galv (material) (depth) 2" (size) If telescope see back.
  - (5) screen (length) (depth to top) SS- (size) (material)
  - (6) pump 1 (HP) (yield gpm) Electric (type power)
  - (7) electric log (yes or no)
  - (organization running log)
  - (8) how well bottom plugged 2" BWV


**CODED**

JUN 13 1971

DRILLERS REMARKS:

If well telescopes please sketch and show depths.

GROUND LEVEL

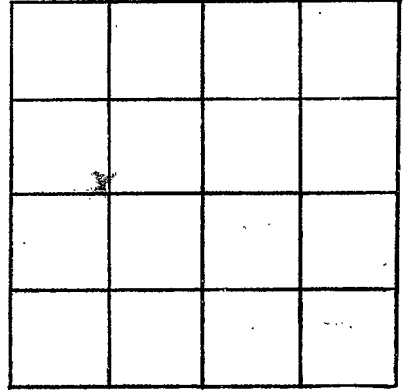

SECTION 11

Please indicate well location X.

ADDITIONAL INFORMATION

If more than one screen, show locations of each on sketch.