

Smith
E 41

MISSISSIPPI
BOARD OF WATER COMMISSIONERS
416 North State Street
Jackson, Mississippi 39201

CODED

WATER WELL DRILLERS LOG

Nov. 20 1985 A-1 Drilling Serv. Inc. Smith
date well completed firm name county well located

LANDOWNER:	description of formations encountered	from	to
J. S. Hipson	Top soil	0	1
Route 3, Box 170	Edwards red clay	1	10
Magee, Ms 39111	tan clay	10	27
(mailing address)	sand	27	56
WELL LOCATION:	clay	56	56 1/2
sec. 33 T. 3 N R. 6 E	sand	56 1/2	73
2 miles S of White Oak	gray clay	73	191
(distance) (direction) (nearest town)	Rock	191	191 1/2
WELL PURPOSE: Home	clay	191 1/2	195
(home, irrigation, municipal, industrial)	dark, messy clay	195	212
WELL COMPLETION DATA:	limestone	212	215
(1) diameter (inches) 2	clay	215	216
(2) total depth (feet) 323	limestone	216	217
(3) static water level (feet) 76 below top of ground.	clay	217	221
(4) casing Galv. St. 211' (material) (depth)	clay w/ hard clay streaks	221	231
— if telescope see back.	sandy clay	231	250
(5) screen 10 1/2' 311' (length) (depth to top)	sand	250	256
2" Stainless Steel (size) (material)	sand w/ clay breaks	256	269
(6) pump 2 (HP) 3 (yield gpm)	clay	269	300
220 V 1 ph (type power)	clay w/ clay streaks	300	309
(7) electric log yes (yes or no)	7. sand w/ clay breaks	309	326
A-1 Logging Serv. (organization running log)	clay	326	330
(8) how well bottom plugged Double B.V. & steel bearings			

CODED

RECEIVED


DEC 5 - 1985

DRILLERS REMARKS:

Poor production - mostly fine powbery silt

If well telescopes please sketch and show depths.

GROUND LEVEL

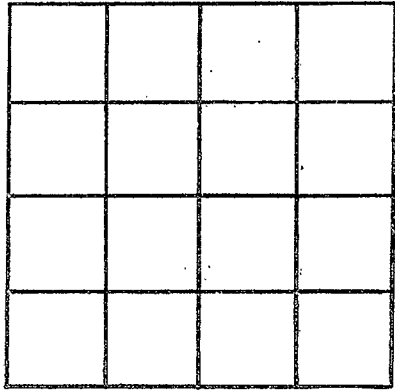

SECTION _____

Please indicate well location X.

ADDITIONAL INFORMATION

If more than one screen, show locations of each on sketch.