

SMITH
E 2000
10-4-76

MISSISSIPPI
BOARD OF WATER COMMISSIONERS
416 North State Street
Jackson, Mississippi 39201

WATER WELL DRILLERS LOG

10-4 date well completed 13T 176 W.K. Barnes W.W. Smith firm name Smith county well located

LANDOWNER: Paul Ray
RT 4
Morton, Miss.
(mailing address)

description of formations encountered	from	to
red clay	0	10
yellow clay	10	25
Blue clay	25	68
Hard Rock	68	75
Blue clay	75	96
Rock	96	99
Blue Clay	99	109
Rock	109	120
Blue clay	120	168
Hard Rock	168	189
Blue clay	189	191
Blue sand	191	200

WELL LOCATION:
sec. 10 T. 3 N R. 6 E
S W
8.37 miles N of White
(distance) (direction) (nearest town)

WELL PURPOSE: Home
(home, irrigation, municipal, industrial)

- WELL COMPLETION DATA:
- (1) diameter (inches) 2
 - (2) total depth (feet) 200
 - (3) static water level (feet) 51 below above top of ground.
 - (4) casing Gelv. (material) (depth)
2 (size) if telescope see back.
 - (5) screen 10 (length) (depth to top)
0.6 (size) S.S. (material)
 - (6) pump 1 (HP) 8 (yield gpm)
Elec (type power)
 - (7) electric log (yes or no)
 - (organization running log)
 - (8) how well bottom plugged Wash


DRILLERS REMARKS:

RECEIVED
APR 4 1977

MISS. BD. OF WATER COMM.

If well telescopes please sketch and show depths.

GROUND LEVEL

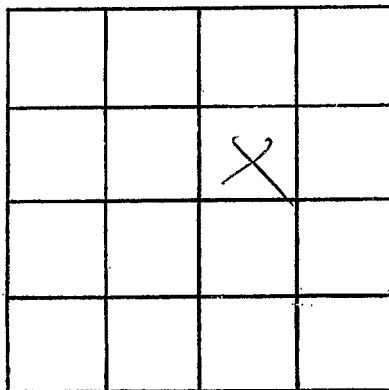

SECTION 10

Please indicate well location X.

ADDITIONAL INFORMATION

If more than one screen,
show locations of each on sketch.