

Smith
E 2001
1-26-77

MISSISSIPPI
BOARD OF WATER COMMISSIONERS
416 North State Street
Jackson, Mississippi 39201

13T

WATER WELL DRILLERS LOG

1-26 77 19 Adcock Water Well Ser. Smith
date well completed firm name county well located

LANDOWNER: Barthly
Adcock
RT 4 Box 96 Marton Miss.
(mailing address)

WELL LOCATION:
sec. 11 T. 3 N. R. 6 E
4 1/2 miles North of White Oak
(distance) (direction) (nearest town)

WELL PURPOSE: Home use
(home, irrigation, municipal, industrial)

- WELL COMPLETION DATA:
- diameter (inches) 2"
 - total depth (feet) 284
 - static water level (feet) 90 below above top of ground.
 - casing clay 1168
(material) (depth)
(size) if telescope see back.
 - screen None (length) (depth to top)
(size) (material)
 - pump 1 5 gal.
(HP) (yield/gpm)
electric
(type power)
 - electric log no
(yes or no)
(organization running log)
 - how well bottom plugged open

| description of formations encountered | from | to |
|---------------------------------------|------|-----|
| Clay + Sand | 0 | 20 |
| Clay + Rock | 20 | 30 |
| clay | 30 | 40 |
| clay | 40 | 50 |
| clay | 50 | 60 |
| clay | 60 | 70 |
| clay | 70 | 80 |
| clay | 80 | 90 |
| clay | 90 | 100 |
| clay + Rock | 100 | 110 |
| clay + rock | 110 | 120 |
| Rock + shell | 120 | 130 |
| Rock + clay | 130 | 140 |
| clay | 140 | 150 |
| clay | 150 | 160 |
| clay | 160 | 170 |
| clay + Sand | 170 | 180 |
| clay + sand | 180 | 190 |
| clay + Sand | 190 | 200 |
| clay + sand | 200 | 220 |
| clay + sand | 220 | 230 |
| clay + sand | 230 | 240 |
| clay + sand | 240 | 250 |
| clay + sand | 250 | 284 |

RECEIVED


MAR 3 1977

DRILLERS REMARKS:

MISS. BD. OF WATER COMMISSIONERS

If well telescopes please sketch and show depths.

GROUND LEVEL

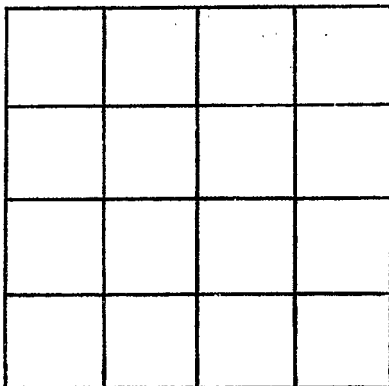

SECTION _____

Please indicate well location X.

ADDITIONAL INFORMATION

If more than one screen, show locations of each on sketch.