

SMITH  
E 2002  
8/25/77

MISSISSIPPI  
BOARD OF WATER COMMISSIONERS  
416 North State Street  
Jackson, Mississippi 39201

WATER WELL DRILLERS LOG

8-25 1977 Alcock W.W. Sew Smith  
date well completed firm name county well located

LANDOWNER: Eric Jones  
Rt 4. Morton Miss.  
39117  
(mailing address)

WELL LOCATION:  
sec. 10 T. 3N R. 6E  
3 1/2 miles North of White Oak  
(distance) (direction) (nearest town)

WELL PURPOSE: Home Use  
(home, irrigation, municipal, industrial)

- WELL COMPLETION DATA:
- (1) diameter (inches) 2"
  - (2) total depth (feet) 213
  - (3) static water level (feet) 45 below above top of ground.
  - (4) casing glw. 203  
(material) (depth)
  - (size) if telescope see back.
  - (5) screen 10 213  
(length) (depth to top)
  - 2" stainless steel  
(size) (material)
  - (6) pump 1/2 P. 4  
(HP) (yield gpm)
  - Electric  
(type power)
  - (7) electric log No  
(yes or no)
  - (organization running log)
  - (8) how well bottom plugged Shark  
Back Wash Valve


description of formations encountered	from	to
clay + sand	0	20
clay + sand	20	75
Rock + clay	75	105
shill + sand	105	113
clay	113	147
sand	147	157
clay	157	168
sand + clay	168	199
sand	199	213

RECEIVED  
SEP 21 1977  
MISS. Bd. OF WATER COMMISSIONERS

DRILLERS REMARKS:

If well telescopes please  
sketch and show depths.

GROUND LEVEL

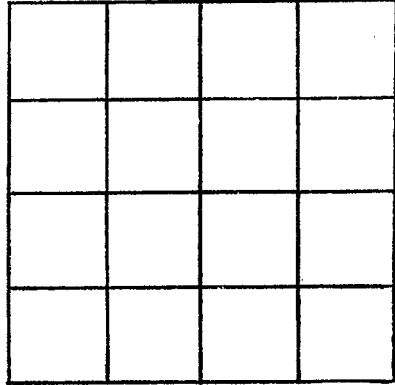

SECTION \_\_\_\_\_

Please indicate well location X.

ADDITIONAL INFORMATION

If more than one screen,  
show locations of each on sketch.