

Smith
E 2003
10/20/77

MISSISSIPPI
BOARD OF WATER COMMISSIONERS
416 North State Street
Jackson, Mississippi 39201

WATER WELL DRILLERS LOG

10-20 1977 date well completed
Edcock W. Sew. firm name
Smith county well located

LANDOWNER: Woodrow
Gibbons
Rt 4 merton miss.
(mailing address)

WELL LOCATION:
sec. 11 T. 3 N R. 6 E
5 miles North White Oak
(distance) (direction) (nearest town)

WELL PURPOSE: Home use
(home, irrigation, municipal, industrial)

WELL COMPLETION DATA:
(1) diameter (inches) 2"
(2) total depth (feet) 258
(3) static water level (feet) 104 below top of ground.
(4) casing glow, 248 (material) (depth)
(size) If telescope see back.
(5) screen 10 feet, 258 (length) (depth to top)
2" stainless steel (size) (material)
(6) pump 1 (HP) 6 (yield gpm)
Elicent (type power)
(7) electric log No (yes or no)
(organization running log)

(8) how well bottom plugged clayton
Mark-Back wash val

description of formations encountered	from	to
Sand + clay	0	21
Sand + clay	21	42
clay	42	122
clay + silt	122	189
clay	189	231
clay + sand	231	248
Sand	248	258
Sand + clay	258	273
clay	273	310


RECEIVED
NOV 22 1977

MISS. BD. OF WATER COMM

DRILLERS REMARKS:

If well telescopes please sketch and show depths.

GROUND LEVEL

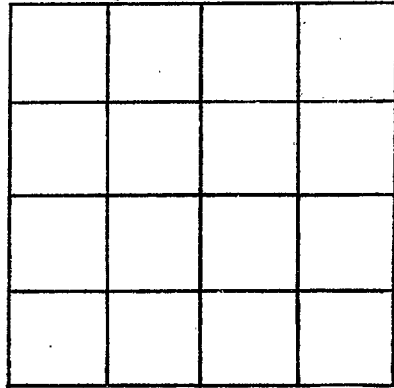

SECTION _____

Please indicate well location X.

ADDITIONAL INFORMATION

If more than one screen,
show locations of each on sketch.