

SMITH
 E2004
 8-11-78

MISSISSIPPI
 BOARD OF WATER COMMISSIONERS
 416 North State Street
 Jackson, Mississippi 39201

WATER WELL DRILLERS LOG

Aug 11 1978 Adcock Water Well Smith
 date well completed firm name county well located

LANDOWNER:
 Nicky Walker
 Rt 2 Morton Miss
 (mailing address) 39117

WELL LOCATION:
 sec. 13 T-3 N R-10 E
 5 miles North of White Oak
 (distance) (direction) (nearest town)

WELL PURPOSE: Home
 (home, irrigation, municipal, industrial)

WELL COMPLETION DATA:
 (1) diameter (inches) 2"
 (2) total depth (feet) 245
 (3) static water level (feet) 120 below top of ground.
 (4) casing galv. 145 (material) (depth)
 (size) if telescope see back.
 (5) screen 10 255 (length) (depth to top)
 2" Stainless (size) (material)
 (6) pump 1 (HP) 4 (yield gpm)
 Elect. (type power)
 (7) electric log NO (yes or no)
 (organization running log)
 (8) how well bottom plugged Shark Backwash valve


description of formations encountered	from	to
clay	0	10
sand + clay	10	30
clay	30	84
clay	84	105
clay	105	126
Clay + Shell	126	137
Rock	137	140
clay	140	164
Rock + shell	164	210
clay + sand	210	245
sand	245	255

RECEIVED
 AUG 23 1978
 MISS. BD. OF WATER COMM

DRILLERS REMARKS:

If well telescopes please sketch and show depths.

GROUND LEVEL

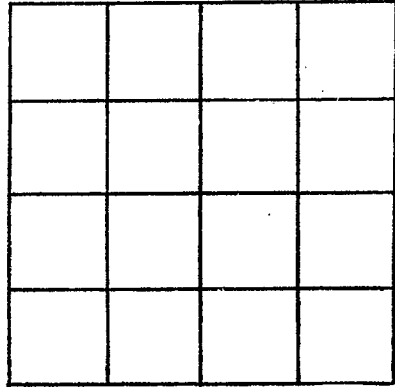

SECTION _____

Please indicate well location X.

ADDITIONAL INFORMATION

If more than one screen, show locations of each on sketch.