

MISSISSIPPI DEPARTMENT OF NATURAL RESOURCES
Bureau of Land and Water Resources
 Southport Mall
 P.O. Box 10631
 Jackson, Mississippi 39209
WATER WELL DRILLERS LOG

Smith
E 2006

7-7

date well completed

1986 Roy V. West

firm name

Smith

county well located

LANDOWNER:
G.S. Isipren
White Oak MS
 (mailing address)

| description of formations encountered | from | to |
|---------------------------------------|-----------|-----------|
| <u>CLAY</u> | <u>0</u> | <u>2</u> |
| <u>SANDY CLAY</u> | <u>2</u> | <u>12</u> |
| <u>SAND</u> | <u>12</u> | <u>16</u> |
| <u>CLAY</u> | <u>16</u> | <u>27</u> |
| <u>SAND</u> | <u>27</u> | <u>75</u> |

WELL LOCATION:
 sec. 3 T. 2 N. R. 6 E.
1 1/2 miles SE of White Oak
 (distance) (direction) (nearest town)

WELL PURPOSE:
 (home, irrigation, municipal, industrial)

- WELL COMPLETION DATA:**
- diameter (inches) 2"
 - total depth (feet) 75'
 - static water level (feet) 35' below above top of ground.
 - casing Pvc, 65'
 (material) (depth)
 (size) if telescope see back.
 - screen 10', 65'
 (length) (depth to top)
2", PVC
 (size) (material)
 - pump 1 (HP) 10 (yield gpm)
REA
 (type power)
 - electric log No
 (yes or no)

RECEIVED
JUL 30 1986

Department of Natural Resources
 Bureau of Land & Water Resources


(organization running log)

(8) how well bottom plugged
WASH UACVE

DRILLERS REMARKS:

If well telescopes please
sketch and show depths.

GROUND LEVEL

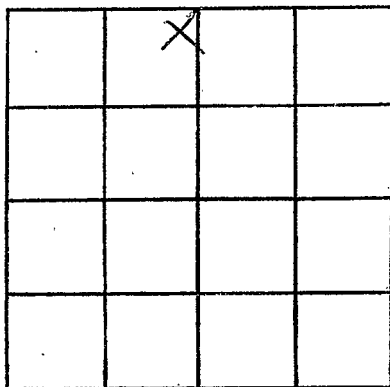

SECTION 3

Please indicate well location X.

ADDITIONAL INFORMATION

If more than one screen,
show locations of each on sketch.