


If well telescopes please sketch and show depths.

GROUND LEVEL

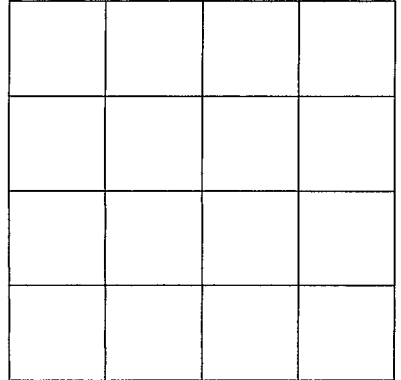

SECTION _____

Please indicate well location X.

ADDITIONAL INFORMATION

GO TO WHITE OAK
GO NORTH TO
SARDIS church
ROAD TAKE 1ST
LEFT ON GRAVEL
ROAD 3 HOUSES
ON LEFT
B. C. ROGERS
PRENTISS Adcock

If more than one screen,
show location of each on sketch.