

5 F 1 *James McGehee*
2-10-61

07

WATER WELL DRILLERS LOG

Date: 2/10, 1961, Driller: James McGee, County Smith.
(Name)

(1) Owner of Land: Braxton L. Hawkins
(Name)
Burns, Miss.
(Address)

(2) Location: SE 1/4, NE 1/4, Sec. 1 T. 3N R. 7E
25 miles South, of Forest.
(distance) (direction) (Nearest Town)

(3) Topography: X
(Hilly) (Flat) (Level)

(4) Purpose of Well: Domestic.
(Domestic Irrigation
Municipal, Industrial, Other)

Description & Color of Materials Sand, Clay, Red Clay, Shell, etc.	Thick- ness Feet	Depth Feet
Brown clay.	0	18
Rock.	18	20
Clay.	20	37
Rock & mucky sand.	37	42
Clay & stks. sand.	42	65
Clay.	65	142
Clay & stks. sand.	142	152
Clay.	152	312
Shale.	312	425
Rock.	425	431
Shale & stks. rock.	431	481
Shale.	481	511
Sandy shell.	511	521
Clay & stks. sand.	521	531
Clay.	531	581
Clay & stks. shale.	581	591
Mucky clay & sand.	591	621
Sand. (Screen set.)	621	641

Information upon completion of well:

(1) Diameter 2 inches.

(2) Total Depth 641 feet.

(3) Water Level 165 feet below top of ground.


(4) Cased to 621', Size 2".

(5) Screen: Size 2", Length 20'.

(6) Were any formations sealed against pollution?
yes, X no.

If YES depth of formation _____
Why _____

Drillers Remarks: Good well.

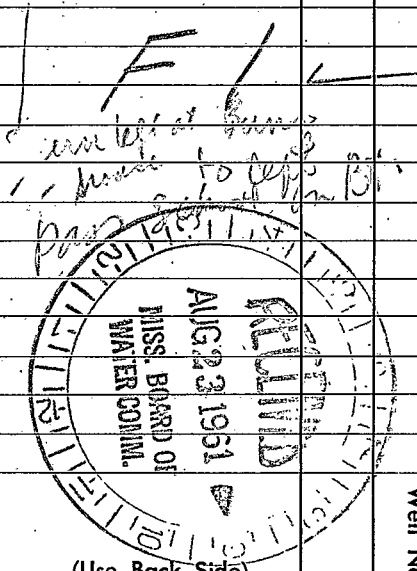

(Use Back Side)

Well No.

