

SMITH  
4 F2  
6-22-61

MISSISSIPPI BOARD OF WATER COMMISSIONERS

WATER WELL DRILLERS LOG

182  
For S?

Date: 6/22, 1961, Driller: Johnnie Beasley County Smith  
(Name)



	Description & Color of Materials Sand, Clay, Red Clay, Shell, etc.	Thick- ness Feet	Depth Feet
(1) Owner of Land: Dewey Arinder (Name)	Red clay & sandy sand	0-	12
P. O. Box 183, Raleigh, Miss (Address)	Yellow sand.	12-	62
(2) Location: SE 1/4, SW 1/4, Sec. 24 T. 3N R. 7E	Sand & gravel.	62-	72
3 miles North, of Raleigh (distance) (direction) (Nearest Town)	Clay & sand.	72-	82
West of Hwy. 35.	Sand & stks. clay.	82-	142
(3) Topography: x (Hilly) (Flat) (Level)	Clay.	142-	172
(4) Purpose of Well: Domestic (Domestic Irrigation Municipal, Industrial, Other)	Clay & stks. shell.	172-	217
	Rock.	217-	222
	Rock & mucky shell.	222-	262
	Soft shell.	262-	292
	Fine sand & stks. clay.	292-	302
	Fine sand. (Screen set)	302-	326

Information upon completion of well:

- (1) Diameter 4" inches.
- (2) Total Depth 326' feet.
- (3) Water Level 200' feet below top of ground.
- (4) Cased to 300', Size 4"
- (5) Screen: Size 2", Length 25'
- (6) Were any formations sealed against pollution?  
yes,  no.

If YES depth of formation \_\_\_\_\_  
Why \_\_\_\_\_

Drillers Remarks: Good well.  
See more details. 1 hp.

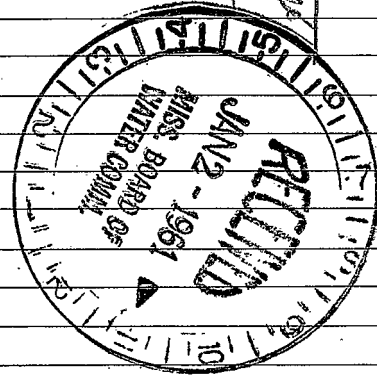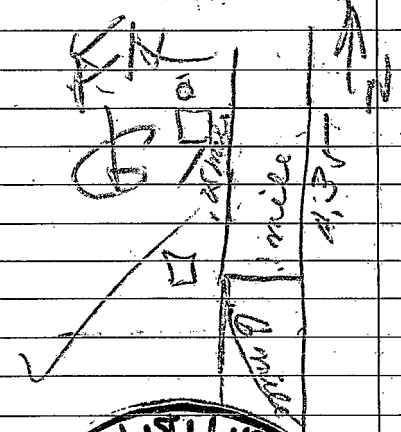

(Use Back Side)

Well No.

