

F.B.3

5-12-64

WATER WELL DRILLERS LOG

Date: 5/12, 1964, Driller: Forest Drilling Co. County: Scott  
 (Name)


(1) Owner of Land: Jessie Baker  
 (Name)  
Raleigh, Miss  
 (Address)  
 (2) Location: 3 31 7E 6 T R  
3 miles South of Prenton  
 (distance) (direction) (Nearest Town)  
 (3) Topography: \_\_\_\_\_  
 (Hilly) (Flat) (Level)  
 (4) Purpose of Well: Home  
 (Domestic Irrigation  
 Municipal, Industrial, Other)

Description & Color of Materials Sand, Clay, Red Clay, Shell, etc.	Thick- ness Feet	Depth Feet
Clay	0	38
Rock		47
Clay + Shale		62
Clay + Shale		92
Shale		112
Shale + Sand		122
Shale		162
Fine Sand		187
Clay + Shale + Sand		199

Information upon completion of well:

(1) Diameter 2 inches.  
 (2) Total Depth 199 feet.  
 (3) Water Level 88 feet below top of ground.  
 (4) Cased to 189, Size 2"  
 (5) Screen: Size 2", Length 10ft  
 (6) Were any formations sealed against pollution?  
 \_\_\_\_\_ yes, X no.

If YES depth of formation \_\_\_\_\_  
 Why \_\_\_\_\_  
 Drillers Remarks: \_\_\_\_\_

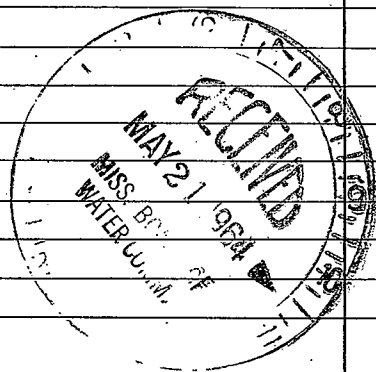

(Use Back Side)

Well No.

