

Smith
374
4-67

MISSISSIPPI
BOARD OF WATER COMMISSIONERS
416 North State Street
Jackson, Mississippi 39201

WATER WELL DRILLERS LOG

April 14 1967 W. H. Butler Smith
date well completed firm name county well located

LANDOWNER:

Walter Sanderford
Raleigh Miss
(mailing address) Rt 1

description of formations encountered

description of formations encountered	from	to
red sand + chalk	1	10
chalk	10	20
sand + chalk	20	60
chalk	60	80
chalk + shell	80	90
chalk	90	104
rock + chalk	104	110
rock	110	140
chalk rock + shell	140	150
chalk + shell	150	160
shell + sand	160	180
shell + granite	180	186
sand	186	222

WELL LOCATION:

sec. 33 T 3 N R 7 E
4 1/2 miles N/W of Raleigh
(distance) (direction) (nearest town)

WELL PURPOSE:

Home (home, irrigation, municipal, industrial)


WELL COMPLETION DATA:

- (1) diameter (inches) 2"
- (2) total depth (feet) 222
- (3) static water level (feet) 45 below top of ground.
- (4) casing 2 1/2" (material), 190' (depth)
2" if telescope see back.
(size)
- (5) screen 10' (length), 190' (depth to top)
2" S. steel (size) (material)
- (6) pump 1 (HP), 12 (yield gpm)
Electric (type power)
- (7) electric log NO (yes or no)
- (organization running log)
- (8) how well bottom plugged 2"
Rock Wash Valve

DRILLERS REMARKS:

If well telescopes please sketch and show depths.

GROUND LEVEL

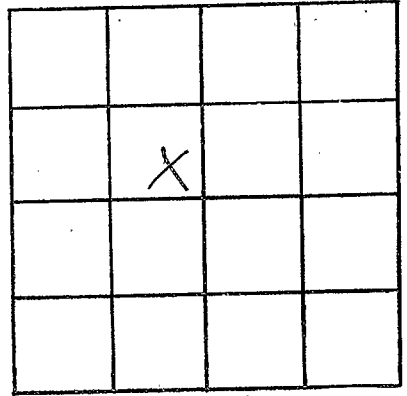

SECTION 33

Please indicate well location X.

ADDITIONAL INFORMATION

If more than one screen, show locations of each on sketch.