

042

SMITH
F 7
4-67

MISSISSIPPI
BOARD OF WATER COMMISSIONERS
416 North State Street
Jackson, Mississippi 39201

WATER WELL DRILLERS LOG

April 2 1967 W. G. Butler Smith
date well completed firm name county well located

LANDOWNER:

T. G. Boykin
Morton, Miss.
Rt. 4 - (mailing address)

description of formations encountered

from to

CLAY	0	20
CLAY + Rock	20	40
CLAY	40	50
CLAY + Shell	50	60
CLAY	60	70
CLAY + Shell	70	90
ROCK	90	110
ROCK + shell	110	120
ROCK + CLAY	120	130
ROCK	130	140
ROCK + CLAY	140	150
ROCK Shell + SAND	150	160
ROCK Shell, lignite	160	180
SAND, rock - lignite	170	180
CLAY + SAND	180	183
CLAY + FINE SAND	183	193
SAND	193	203
SAND + CLAY	203	213
SAND, CLAY + ROCK	213	223
SAND	223	243

WELL LOCATION:


sec. 6 T 3 N R 7 E
S W
3 miles S of Trenton
(distance) (direction) (nearest town)

WELL PURPOSE:

HOME (home, irrigation, municipal, industrial)

WELL COMPLETION DATA:


- (1) diameter (inches) 2"
- (2) total depth (feet) 243
- (3) static water level (feet) _____ below top of ground.
- (4) casing 93/16, 226, (material) (depth)
2" If telescope see back. (size)
- (5) screen 10', 226 (length) (depth to top)
2", S.S. (size) (material)
- (6) pump AIR COMP (HP) (yield gpm)
Electric (type power)
- (7) electric log No (yes or no)
(organization running log)
- (8) how well bottom plugged 2" B.W.

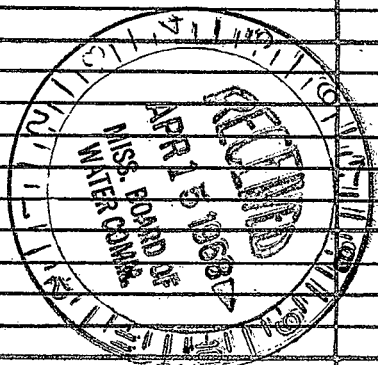

DRILLERS REMARKS:

If well telescopes please sketch and show depths.

GROUND LEVEL

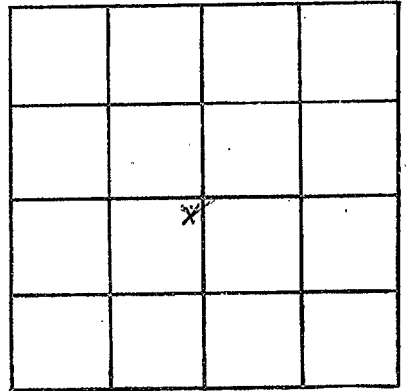

SECTION 6

Please indicate well location X.

ADDITIONAL INFORMATION

If more than one screen, show locations of each on sketch.