

Smith
F8
3-23-70

MISSISSIPPI
BOARD OF WATER COMMISSIONERS
416 North State Street
Jackson, Mississippi 39201

WATER WELL DRILLERS LOG

3-23-1970 date well completed
W.K. Barnes Water Wells firm name
Smith county well located

LANDOWNER: Harold Arendley
Raleigh miss.
Route one
(mailing address) 073

description of formations encountered	from	to
Red Clay	0	8
Red Sand	8	22
yellow clay	22	60
yellow sand clay	60	94
mixed	94	125
Fine Sand		

WELL LOCATION:
sec. 24 T. 3 S. R. 7 E. W. 4
4 miles north of Raleigh
(distance) (direction) (nearest town)

WELL PURPOSE: Chicken House
(home, irrigation, municipal, industrial)

WELL COMPLETION DATA:
(1) diameter (inches) 2
(2) total depth (feet) 125
(3) static water level (feet) 104 below top of ground.
(4) casing Galv. 121 (material) (depth)
2" (size) if telescope see back.
(5) screen 4' (length) (depth to top)
07" (size) Stainless Steel (material)
(6) pump 1 1/2 (HP) 8 (yield gpm)
Elec (type power)
(7) electric log no (yes or no)
(organization running log)
(8) how well bottom plugged Wash valve


JUN 4 1970

MISS. BD. OF
WATER COMMISSIONERS

DRILLERS REMARKS:

If well telescopes please sketch and show depths.

GROUND LEVEL

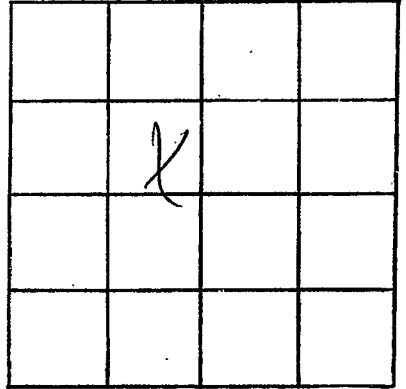

SECTION 24

Please indicate well location X.

ADDITIONAL INFORMATION

If more than one screen,
show locations of each on sketch.