

MISSISSIPPI
BOARD OF WATER COMMISSIONERS
416 North State Street
Jackson, Mississippi 39201

CODED

WATER WELL DRILLERS LOG

SMITH
F9
12-4-70

12-4
date well completed

1970 Forest Drilling
firm name

Smith
county well located

LANDOWNER:

W.C. Taylor
Route 1 Raleigh
Burns, Miss.
(mailing address)

description of formations
encountered

from to

Brown clay	0	24
Clay	24	61
Stk. Rock + clay	61	87
Stk. Rock + Clay	87	102
Stk. Clay + silt clay	102	143
fine sand + lt. silt clay	143	151
fine silt + clay	151	163
Stk. fine sand + clay	163	184
clay	184	225
	225	287

WELL LOCATION:

sec. 31 T3 N R 7 E
5 miles Southwest of Burns
(distance) (direction) (nearest town)

WELL PURPOSE: Home
(home, irrigation, municipal, industrial)

WELL COMPLETION DATA:

- diameter (inches) 2"
- total depth (feet) 163'
- static water level (feet) _____ below above top of ground.
- casing steel, 153' (material) (depth)
2" (size) if telescope see back.
- screen 10' (length) 153' (depth to top)
2" stainless steel (size) (material)
- pump 2 HP, 912 AIR (HP) (yield gpm)
Elect. 220V (type power)
- electric log No (yes or no)
- (organization running log)

(8) how well bottom plugged 2"
backwash valve

DRILLERS REMARKS:


CODED

FEB 1 1971

MISS. Bd. of
WATER COMMISSIONERS

If well telescopes please sketch and show depths.

GROUND LEVEL

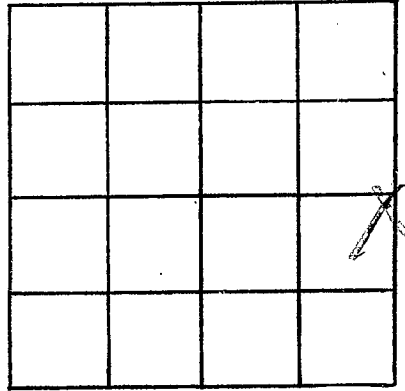

SECTION 21

Please indicate well location X.

ADDITIONAL INFORMATION

If more than one screen, show locations of each on sketch.