

Smith
 F 10
 8-20-75

MISSISSIPPI
 BOARD OF WATER COMMISSIONERS
 416 North State Street
 Jackson, Mississippi 39201

CODED

WATER WELL DRILLERS LOG

Aug 20 - 1975 W. G. Butler Smith
 date well completed firm name county well located


LANDOWNER:	description of formations encountered	from	to
B.C. Rogers farm	Clay	0	10
Gen Harris Jennant	Clay + sand	10	20
Pulaski (mailing address) Miss	Sand	20	25
WELL LOCATION:	Clay	25	40
sec. 1 T. 3 N. R. 7 E. 13p	(Sand)	40	50
6 miles N of Raleigh	Clay	50	80
(distance) (direction) (nearest town)	Clay sand	70	80
WELL PURPOSE: Home	Clay	80	87
(home, irrigation, municipal, industrial)	sand	87	90
WELL COMPLETION DATA:	clay	90	95
(1) diameter (inches) 3"			
(2) total depth (feet) 75'			
(3) static water level (feet) _____ below above top of ground.			
(4) casing galv. 69' (material) (depth)			
2" (size) if telescope see back.			
(5) screen 10' 5269' (length) (depth to top)			
2" (size) S.S. (material)			
(6) pump _____ (HP) _____ (yield gpm)			
electric (type power)			
(7) electric log No (yes or no)			
(organization running log)			
(8) how well bottom plugged 2" B.W.K.			
DRILLERS REMARKS:			

RECEIVED
 SEP 24 1975

MISS. BD. OF WATER COMMISSIONERS

If well telescopes please sketch and show depths.

GROUND LEVEL

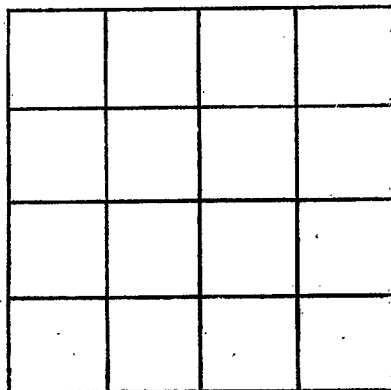

SECTION _____

Please indicate well location X.

ADDITIONAL INFORMATION

If more than one screen, show locations of each on sketch.