

Smith
F-11
2-14-80

MISSISSIPPI
BOARD OF WATER COMMISSIONERS CODED
416 North State Street
Jackson, Mississippi 39201

WATER WELL DRILLERS LOG

2-14-80 Griner Drilling Smith
date well completed firm name county well located

LANDOWNER:
New and Hughes
P.O. Drawer 1487
Natchez, MS 39120
(mailing address)

description of formations encountered	from	to
TOP SOIL	0	21
chalk-rock	21	210
chalk	210	525
Sand streaked	525	567
chalk	567	585

WELL LOCATION: 660' N + 2314' E
No. 1 of Sec. 16 T-3 R-7 SW/4
Sd. of
SUPV. Raleigh
(distance) miles (direction) of (nearest town)

WELL PURPOSE: oil field supply
(home, irrigation, municipal, industrial)

WELL COMPLETION DATA:
(1) diameter (inches) 3"
(2) total depth (feet) 580'
(3) static water level (feet) 180' ^{below} top of ground
(4) casing 567' steel (material) (depth)
3" (size) if telescope see back.
(5) screen 42' 525' (length) (depth to top)
3" perforated (size) (material)
(6) pump — 50 (HP) (yield gpm)
AC (type power)
(7) electric log — (yes or no)
(organization running log)

(8) how well bottom plugged orange
peel

DRILLERS REMARKS:


DEPT. OF NATURAL RESOURCES
BUREAU OF LAND & WATER RESOURCES

MAR 11 1980

RECEIVED

If well telescopes please sketch and show depths.

GROUND LEVEL

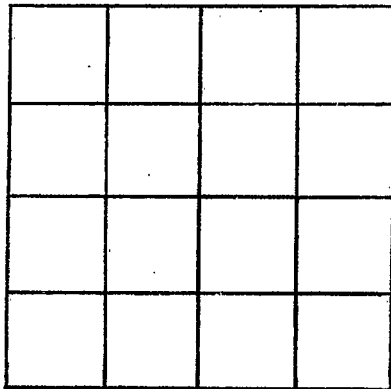

SECTION _____

Please indicate well location X.

ADDITIONAL INFORMATION

If more than one screen, show locations of each on sketch.