

MISSISSIPPI DEPARTMENT OF NATURAL RESOURCES

Bureau of Land and Water Resources

Southport Mall

P.O. Box 10631

Jackson, Mississippi 39209

WATER WELL DRILLERS LOG

SMITH
F12
10/27/82
10/27

1982 TOM GRIFFITH
PLUMBING & WELL SERVICE, INC.
firm name

Smith
county well located

LANDOWNER:

R. E. Williams Drilling Co.

Lease: X.M. Frascogna
(mailing address)

WELL LOCATION:

sec. 16 T. 30 N R. 7 E
S W
8 miles NW of Raleigh
(distance) (direction) (nearest town)
Miss.

WELL PURPOSE: Oil Loc.
(home, irrigation, municipal, industrial)

WELL COMPLETION DATA:

- (1) diameter (inches) 3"
- (2) total depth (feet) 145'
- (3) static water level (feet) 20' below top of ground.
- (4) casing Steel, 105'
(material) (depth)
N/A if telescope see back.
(size)
- (5) screen 40' 105'
(length) (depth to top)
3" steel slots
(size) (material)
- (6) pump None 70
(HP) (yield gpm)
Electric airlift
(type power)
- (7) electric log none
(yes or no)
N/A
(organization running log)
- (8) how well bottom plugged welded
plugged

description of formations encountered

from to

Sand - Chalk	1	18
Hard Rock	18	19
Chalk	19	25
Hard Rock	25	28
Chalks	28	30
Hard Rock	30	35
Chalk	35	90
Sand	90	145

2318° S E 1900° E
NW cor

CODED

DEPT. OF NATURAL RESOURCES
BUREAU OF LAND & WATER RESOURCES


JAN 28 1983

RECEIVED

DRILLERS REMARKS:

If well telescopes please sketch and show depths.

GROUND LEVEL

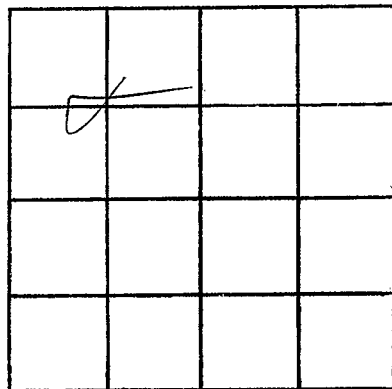

SECTION 16

Please indicate well location X.

ADDITIONAL INFORMATION

If more than one screen,
show locations of each on sketch.