

MISSISSIPPI DEPARTMENT OF NATURAL RESOURCES

Bureau of Land and Water Resources

Southport Mall

P.O. Box 10631

Jackson, Mississippi 39209

WATER WELL DRILLERS LOG

SMITH
FIS

251302D

CODED

Griner Drilling Service, Inc.

Smith

5-16-90 date well completed

Griner Drilling Service, Inc. firm name

county well located

| LANDOWNER: | description of formations encountered | from | to |
|--|---------------------------------------|------|-----|
| Norcen Explorer, Inc. 550 Westlake Blvd. Suite 350 Houston, Texas 77079 | clay, sand, rock | 0 | 570 |
| | sand | 570 | 620 |

WELL LOCATION: 1475'S + 1280'E

sec. 1 T. 30N R. 7E NW/4

No. 1 Burns
Burns
Barwick
3 miles (direction) of (nearest town)

WELL PURPOSE: oilfield rig supply
(home, irrigation, municipal, industrial)

WELL COMPLETION DATA:

- (1) diameter (inches) 3"
- (2) total depth (feet) 620'
- (3) static water level (feet) 125' below top of ground.

(4) casing PVC 540' (material) (depth)

3" (size) if telescope see back.

(5) screen 80' From 540' to 620' (length) (depth to top)

3" PVC slotted (size) (material)

(6) pump - 70-75 (HP) (yield gpm)

AC (type power)

(7) electric log (yes or no)

(organization running log)

(8) how well bottom plugged 3" plug

RECEIVED


JUN 18 1990

Department of Natural Resources
Bureau of Land & Water Resources

DRILLERS REMARKS:

If well telescopes please sketch and show depths.

GROUND LEVEL

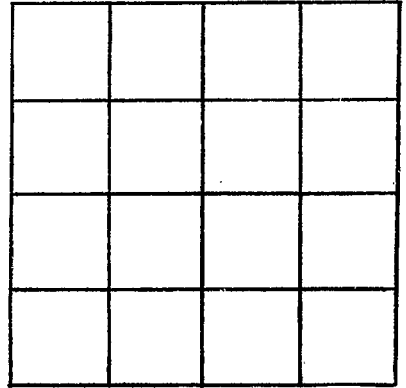

SECTION _____

Please indicate well location X.

ADDITIONAL INFORMATION

If more than one screen,
show locations of each on sketch.