

MISSISSIPPI DEPARTMENT OF NATURAL RESOURCES

Bureau of Land and Water Resources

Southport Mall

P.O. Box 10631

251B

Jackson, Mississippi 39209

WATER WELL DRILLERS LOG

SMITH  
F 17  
2-19-91

Caled

Griner Drilling Service, Inc.

Smith

2-19-91  
date well completed

Griner Drilling Service, Inc.  
firm name

Smith  
county well located

Lease: No. 1 John C. Henderson et al

LANDOWNER:  
Noreen Explorers  
550 Westlake Blvd.  
Suite 350  
Houston, Texas 77079  
(mailing address)

description of formations encountered	from	to
clay & sand	0	150
clay, rock, sand	150	650
sand	650	703
clay & sand	703	803

WELL LOCATION: 100'S & 700'E  
sec. 1 T 30N R 7E of  
Burns Field  
(distance) (direction) (nearest town)

WELL PURPOSE: oilfield rig  
(home, irrigation, municipal, industrial)  
supply

WELL COMPLETION DATA:

- (1) diameter (inches) 3"
- (2) total depth (feet) 803'
- (3) static water level (feet) 150' <sup>below</sup> top of ground
- (4) casing PVC 663' (material) (depth)  
3" (size) if telescope see back.
- (5) screen 40' 663' to 703' (length) (depth to top)  
3" PVC screen (size) (material)
- (6) pump Airlift 70 (HP) (yield gpm)  
A/C (type power)
- (7) electric log (yes or no)  (no)
- (organization running log)
- (8) how well bottom plugged PVC plug 3"

RECEIVED


FEB 28 1991

Dept. of Environmental Quality  
Bureau of Land & Water Resources

DRILLERS REMARKS:

If well telescopes please sketch and show depths.

GROUND LEVEL

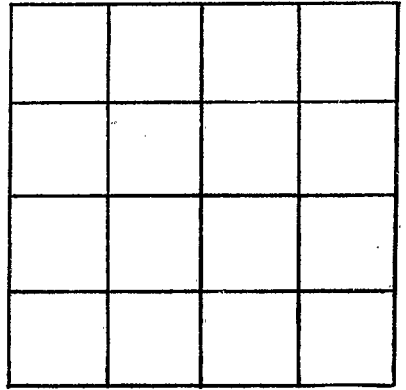

SECTION \_\_\_\_\_

Please indicate well location X.

ADDITIONAL INFORMATION

If more than one screen,  
show locations of each on sketch.