

Smith  
F2000  
11/4/77

MISSISSIPPI  
BOARD OF WATER COMMISSIONERS  
416 North State Street  
Jackson, Mississippi 39201

WATER WELL DRILLERS LOG

11-4 date well completed      1977 Adcock W.W. Serv. firm name      Smith county well located

LANDOWNER:  
W.C. Taylor  
Rt 1 Raleigh Miss  
(mailing address)

WELL LOCATION:  
sec 22 T 3 N R 7 E  
8 miles NE of Raleigh Miss  
(distance) (direction) (nearest town)

WELL PURPOSE: Domestic  
(home, irrigation, municipal, industrial)

- WELL COMPLETION DATA:
- (1) diameter (inches) 2"
  - (2) total depth (feet) 163
  - (3) static water level (feet) 50 below top of ground.
  - (4) casing galv. 15.3 (material) (depth)  
2 (size) if telescope see back.
  - (5) screen 10 163 (length) (depth to top)  
2" stainless (size) (material)  
air compressor
  - (6) pump 3 15 (HP) (yield gpm)  
Elect. (type power)
  - (7) electric log No. (yes or no)

(organization running log)  
(8) how well bottom plugged Clayton  
Mark back wash Cole


DRILLERS REMARKS:

description of formations encountered	from	to
Clay	0	10
Clay + Sand	10	21
Clay	21	42
Clay + Rock	42	63
Rock	63	84
Rock	84	105
Sand + Shale	105	115
Clay	115	147
Clay	147	150
Sand	150	163
Clay + fine sand	163	210

RECEIVED  
NOV 22 1977

If well telescopes please  
sketch and show depths.

GROUND LEVEL

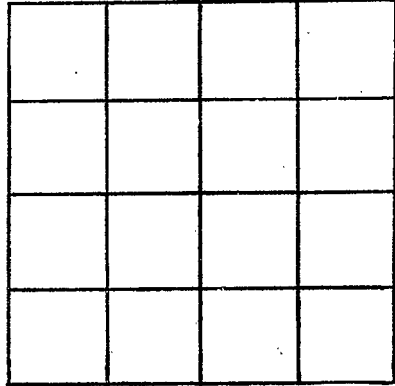

SECTION \_\_\_\_\_

Please indicate well location X.

ADDITIONAL INFORMATION

If more than one screen,  
show locations of each on sketch.