

SMITH
 F 2001
 1-23-78

MISSISSIPPI
 BOARD OF WATER COMMISSIONERS
 416 North State Street
 Jackson, Mississippi 39201

WATER WELL DRILLERS LOG

123 1978 adcock water well Sew. Smith
 date well completed firm name county well located

LANDOWNER: Tom Walker
Rt 1 Raleigh
 (mailing address)

WELL LOCATION:
 sec. 10 T. 3 N. R. 7 E
8 miles N.W. of Raleigh
 (distance) (direction) (nearest town)

WELL PURPOSE: None use
 (home, irrigation, municipal, industrial)

WELL COMPLETION DATA:

(1) diameter (inches) 2

(2) total depth (feet) 115

(3) static water level (feet) 15 below top of ground.

(4) casing galv. (material) 110 (depth)
2 if telescope see back. (size)

(5) screen 5 (length) 115 (depth to top)
2 (size) stainless steel (material)

(6) pump 3/4 (HP) 6 gal. (yield/gpm)
Elect. (type power)

(7) electric log No. (yes or no)
 (organization running log)

(8) how well bottom plugged Wale

description of formations encountered	from	to
clay sand	0	21
clay	21	42
clay	42	63
clay & sand	63	84
clay sand	84	105
Dead	105	115


RECEIVED
 JAN 27 1978

MISS. BD. OF WATER COMM

DRILLERS REMARKS:

If well telescopes please sketch and show depths.

GROUND LEVEL

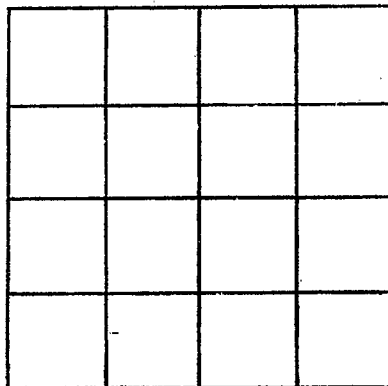

SECTION _____

Please indicate well location X.

ADDITIONAL INFORMATION

If more than one screen, show locations of each on sketch.