

Smith
 FEB 2004
 11-26-84

MISSISSIPPI
 BOARD OF WATER COMMISSIONERS
 416 North State Street
 Jackson, Mississippi 39201

WATER WELL DRILLERS LOG

TOM GRIFFITH

11-26 1984 date well completed
 PLUMBING & WELL SERVICE, INC. firm name
 Smith county well located

LANDOWNER: David & New P.O. Box 1487 Natchez, MS 39120 (mailing address)	description of formations encountered Clay Rock Sand	from 1 10 98	to 10 98 140
---	---	-----------------------	-----------------------

WELL LOCATION:
 sec. 29 T 3 N R 2 E
 S W
 4 miles NW of Raleigh
 (distance) (direction) (nearest town)

WELL PURPOSE: oil loc.
 (home, irrigation, municipal, industrial)

WELL COMPLETION DATA:

- (1) diameter (inches) 3"
- (2) total depth (feet) 140
- (3) static water level (feet) 30 below top of ground.
- (4) casing PVC, 100 (material) (depth)
 n/a if telescope see back. (size)
- (5) screen 40, 100 (length) (depth to top)
 3" PVC (size) (material)
- (6) pump 1/4, 45 (HP) (yield gpm)
 diaphragm (type power)
- (7) electric log no (yes or no)
 n/a (organization running log)
- (8) how well bottom plugged 130W


DRILLERS REMARKS:

RECEIVED
 NOV 20 1985

Department of Natural Resources
 Bureau of Land & Water Resources

If well telescopes please sketch and show depths.

GROUND LEVEL

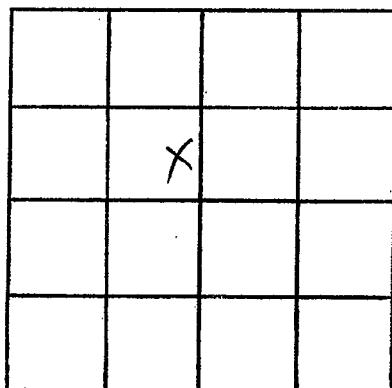

SECTION _____

Please indicate well location X.

ADDITIONAL INFORMATION

If more than one screen,
show locations of each on sketch.