

MISSISSIPPI DEPARTMENT OF NATURAL RESOURCES

Bureau of Land and Water Resources

Southport Mall

P.O. Box 10631

Jackson, Mississippi 39209

WATER WELL DRILLERS LOG

SMITH
F 2005

Oct 10 1985 Roy W. West Drilling Smith
date well completed firm name county well located

LANDOWNER:
J. M. Velventer
Raleigh MS
(mailing address)

description of formations encountered	from	to
SANDY CLAY	0	6
CLAY	6	73
SAND	73	76
CLAY	76	107
SAND	107	118

WELL LOCATION:
sec. 3 T 3 N R 7 E
15 miles N of Raleigh
(distance) (direction) (nearest town)

WELL PURPOSE:
(home, irrigation, municipal, industrial)

- WELL COMPLETION DATA:
- (1) diameter (inches) 2"
 - (2) total depth (feet) 118'
 - (3) static water level (feet) 68' below top of ground.
 - (4) casing PVC, 113' (material) (depth)
(size) If telescope see back.
 - (5) screen 5' 113' (length) (depth to top)
2" PVC (size) (material)
 - (6) pump 1 (HP) 8 (yield gpm)
REA (type power)
 - (7) electric log No (yes or no)
(organization running log)
 - (8) how well bottom plugged WASH VALVE


RECEIVED
NOV - 4 1985

Department of Natural Resources
Bureau of Land & Water

DRILLERS REMARKS:

If well telescopes please sketch and show depths.

GROUND LEVEL

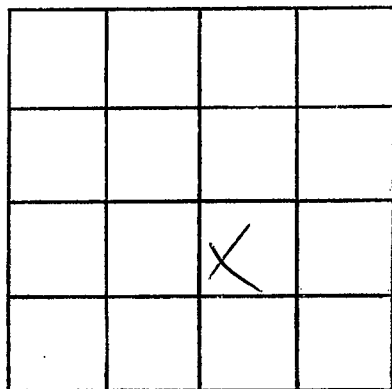

SECTION 3

Please indicate well location X.

ADDITIONAL INFORMATION

If more than one screen, show locations of each on sketch.