

**MISSISSIPPI DEPARTMENT OF ENVIRONMENTAL QUALITY**  
Bureau of Land and Water Resources

P. O. Box 10631  
Jackson, MS 39289-0631  
**WATER WELL DRILLERS LOG**

COUNTY WELL LOCATED <b>SMITH</b>	
WELL NUMBER <b>F2008</b>	CODED
DATE WELL COMPLETED <b>12-21-93</b>	

PERMIT NUMBER
NAME OF DRILLING FIRM <b>PARKER well SERVICE</b>

NAME & MAILING ADDRESS OF LANDOWNER <b>WILSON HALLMAN FOREST MISS.</b>		
WELL LOCATION: SEC <b>3</b> TOWNSHIP <b>3</b> RANGE <b>7</b>		
DISTANCE <b>6</b> Miles	DIRECTION <b>NW</b>	NEAREST TOWN <b>RALPH</b>
OTHER LANDMARK <b>BOYKIN CHURCH ROAD</b>		
WELL PURPOSE: Home, Irrigation, Municipal, Industrial, Fish Pond, etc. <b>CHICKEN HOUSES</b>		

<b>PUMP DATA</b>		
PUMP TYPE (Circle One): <input checked="" type="checkbox"/> Submersible, Turbine, Jet, Flowing Well, Other (Describe) _____		
POWER TYPE (Circle One): <input checked="" type="checkbox"/> Electric, Tractor, Diesel, Gasoline, Butane, Other (Describe) _____ H/P <b>3</b>		
Pump Capacity (GPM) <b>15</b>	No. of Stages <b>11</b>	Setting Depth <b>140</b> FT.
PUMP TEST		
Well yielded <b>15</b> GPM with a drawdown of <b>0</b> ft. after <b>2 1/2</b> hours of pumping		

<b>WELL DATA</b>		
Well Depth <b>561</b>	Casing Diameter (In.) <b>300-2611</b>	Casing Length (Ft.) <b>541</b>
Type of Casing <b>PVC</b>	Hole Depth <b>561</b>	Depth to Static Water Level <b>80'</b>
TYPE OF COMPLETION: (Circle One or More): <input checked="" type="checkbox"/> Gravel Packed, Underreamed, Telescoped, Natural Development, Open Hole, Other (Describe) _____		
Top of Lap Pipe or Reduction in Casing <b>FEET</b> IF TELESCOPED OR MORE THAN ONE SCREEN: USE BACK PAGE		

<b>LOG DATA</b>	
TYPE OF LOG RUN (Circle One): <input type="checkbox"/> No Log Run, Electric, Gamma Ray, Density, Sonic, Neutron, Other (Describe) _____	
Name of Organization Running Log	

<b>SCREEN DATA</b>		
Diameter - Inches <b>2"</b>	Length - Feet <b>20'</b>	Slot Size - Inches <b>006</b>
Screen Type <b>PVC</b>	Depth to Bottom - Feet <b>561</b>	

<b>GEOLOGIC DATA (Office Use Only)</b>			
Surface Elev.	Geologic Unit	Unit Thickness	Depth to Top
Subs. SWL	Date	Analysis	Aquifer Test

Driller's Remarks <b>TESTED TOP SAND NOT ENOUGH WATER DRILLED TO 561</b>
---


DESCRIPTION OF FORMATIONS ENCOUNTERED	FROM	TO	FORMATIONS (Continued)	FROM	TO
<b>CLAY</b>	<b>0</b>	<b>60</b>	<b>PLENTY WATER</b>		
<b>CLAY AND SAND</b>	<b>60</b>	<b>90</b>			
<b>CLAY</b>	<b>90</b>	<b>531</b>			
<b>SAND</b>	<b>531</b>	<b>561</b>			

**RECEIVED**

**JAN 13 1994**

If well telescopes please sketch and show depths.

GROUND LEVEL

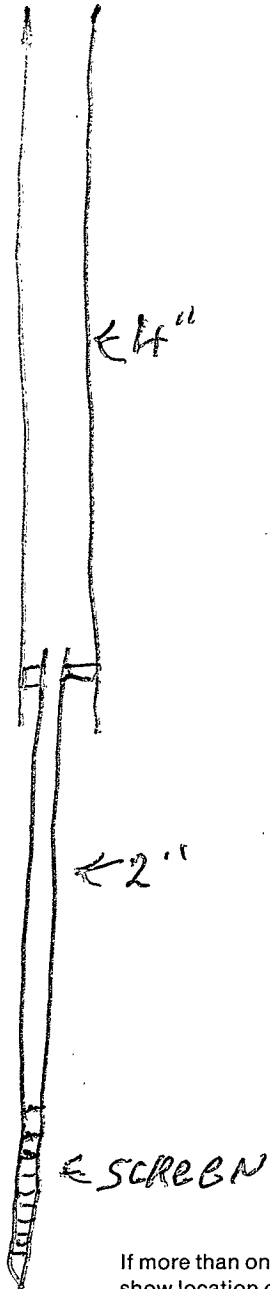

If more than one screen, show location of each on sketch.

7-E


3-N

SECTION 3

Please indicate well location X.

ADDITIONAL INFORMATION

Additional information section consisting of multiple horizontal lines for text entry.