

Smith
363
3-67

**MISSISSIPPI
BOARD OF WATER COMMISSIONERS**
416 North State Street
Jackson, Mississippi 39201

WATER WELL DRILLERS LOG

3-6 1967 Eriner Drilling Service, Inc. Smith
 date well completed firm name county well located

LANDOWNER: B.L. Spearman
Raleigh, Mississippi
 (mailing address)

WELL LOCATION:
2140' N + W of SE/cor Sec.
 sec 34 - T 3N - R 8E
4 miles ENE of Raleigh
 (distance) (direction) (nearest town)

description of formations encountered	from	to
Sand	0	50
Clay	50	205
Rock	205	225
Clay	225	510
Sand	510	525
CLAY	525	715
Sand	715	765


WELL PURPOSE: industrial
 (home, irrigation, municipal, industrial)

- WELL COMPLETION DATA:
- (1) diameter (inches) 3"
 - (2) total depth (feet) 765'
 - (3) static water level (feet) 204' ^{below} / ^{above} top of ground.
 - (4) casing Steel, 725'
 (material), (depth)
 _____ If telescope see back.
 (size)
 - (5) screen 40', 725'
 (length), (depth to top)
3, Steel
 (size), (material)
 - (6) pump AIR, 60
 (HP), (yield gpm)

 (type power)
 - (7) electric log No
 (yes or no)

 (organization running log)
 - (8) how well bottom plugged _____


PH 8.0
IRON .1 PPM

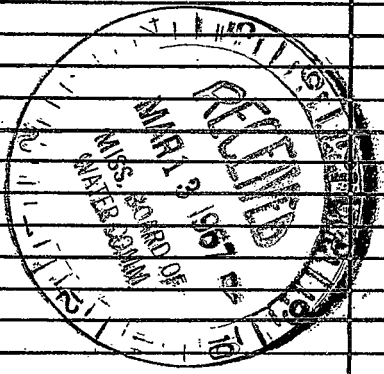

DRILLERS REMARKS: Supply Well for Oil Rig

If well telescopes please sketch and show depths.

GROUND LEVEL

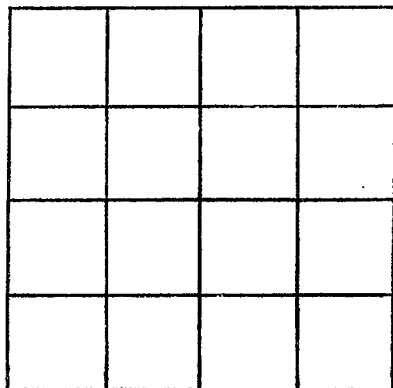

SECTION _____

Please indicate well location X.

ADDITIONAL INFORMATION

If more than one screen,
show locations of each on sketch.