

**MISSISSIPPI
BOARD OF WATER COMMISSIONERS**
416 North State Street
Jackson, Mississippi 39201

WATER WELL DRILLERS LOG

Smith
7-69 CODED
7-108

7-8-68 date well completed *W.K. Banner water wells* firm name *Smith* county well located

LANDOWNER: *Homer Mc Daniels*
Route 2
Raleigh miss
(mailing address)

WELL LOCATION:
sec. *33* T. *3* N. R. *8* E.
S. W.
3 miles *North* of *Raleigh*
(distance) (direction) (nearest town)

description of formations encountered	from	to
<i>Red Clay</i>	<i>0</i>	<i>5</i>
<i>yellow</i>	<i>5</i>	<i>15</i>
<i>Blue Clay</i>	<i>15</i>	<i>30</i>
<i>Fine Blue Sand</i>	<i>30</i>	<i>48</i>
<i>Water Sand</i>	<i>48</i>	<i>55</i>

WELL PURPOSE: *Home use*
(home, irrigation, municipal, industrial)

WELL COMPLETION DATA:

(1) diameter (inches) *2*

(2) total depth (feet) *55*

(3) static water level (feet) *23* below above top of ground.

(4) casing *2"* (*51'* depth)
(material) (depth)
2" if telescope see back.
(size)

(5) screen *4'* (*4'* length) (*4'* depth to top)
2" (*Stainless Steel* material)
(size) (material)

(6) pump *3/4* (*10* yield gpm)
(HP) (yield gpm)
Elec.
(type power)

(7) electric log *no.*
(yes or no)

(organization running log)

(8) how well bottom plugged *Wash Valve*


CODED

AUG 8 1968
MISS. BD. OF
WATER COMM.

DRILLERS REMARKS:

If well telescopes please
sketch and show depths.

GROUND LEVEL

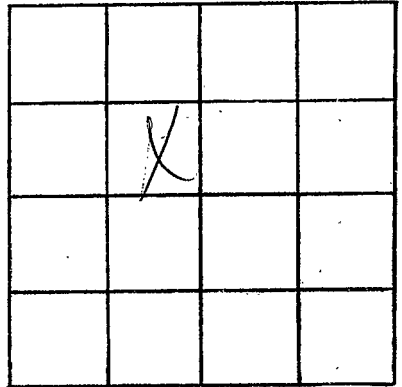

SECTION 33

Please indicate well location X.

ADDITIONAL INFORMATION

If more than one screen,
show locations of each on sketch.