

CODED

Smith
G 5
10-31-69

MISSISSIPPI
BOARD OF WATER COMMISSIONERS
416 North State Street
Jackson, Mississippi 39201

WATER WELL DRILLERS LOG

10-31 date well completed 1969 W. K. Barnes Water wells & Smith firm name Smith county well located

LANDOWNER: Mavis Saxon
Raleigh miss
(mailing address)

WELL LOCATION:
sec 35 T-3 N R-8 E
S W
7 miles East of Raleigh miss
(distance) (direction) (nearest town)

WELL PURPOSE: Home use
(home, irrigation, municipal, industrial)

WELL COMPLETION DATA:
(1) diameter (inches) 2
(2) total depth (feet) 504
(3) static water level (feet) 70 below above top of ground.
(4) casing Galv., 446,
(material) (depth)
2" if telescope see back.
(size)
(5) screen 8'
(length) (depth to top)
8 Shot, Stainless Steel
(size) (material)
(6) pump 1-H.P. 10
(HP) (yield gpm)
Elec
(type power)
(7) electric log no
(yes or no)
(organization running log)
(8) how well bottom plugged Wash water

description of formations encountered	from	to
Red clay	0	4
yellow clay	4	15
yellow sand	15	28
Blue Clay	28	270
Hard rock	270	291
Blue Clay	291	350
Hard rock	350	361
fine sand	361	382
Blue Clay	382	460
fine sand	460	480
Coarse sand	480	504


JAN - 5 1970

MISS. DIV. OF
WATER RESOURCES

DRILLERS REMARKS:

If well telescopes please sketch and show depths.

GROUND LEVEL

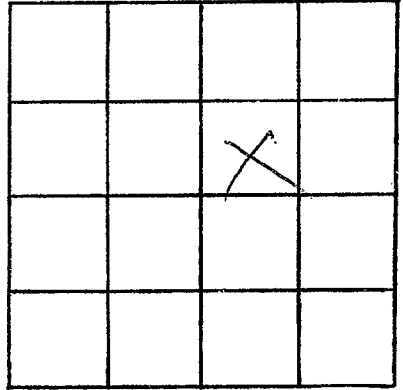

SECTION 35

Please indicate well location X.

ADDITIONAL INFORMATION

If more than one screen,
show locations of each on sketch.