

CODED

my copy

MISSISSIPPI BOARD OF WATER COMMISSIONERS
416 North State Street
Jackson, Mississippi 39201

WATER WELL DRILLERS LOG

Smith

G 6

12-69

Dec 1969
date well completed

Wilkinson Drilling
firm name

Smith
county well located

LANDOWNER: B M Ward

description of formations encountered

from

to

Raleigh Miss
(mailing address)

CLAY + SAND	0	40
blue CLAY	40	200
blue in Rock	200	214
blue clay shale	214	380
gravel	380	430
SAND	430	490

WELL LOCATION:

sec. 13 T 3 N R 8 E
S

5 miles S.W. of Pineville
(distance) (direction) (nearest town)

WELL PURPOSE: home
(home, irrigation, municipal, industrial)

WELL COMPLETION DATA:

- (1) diameter (inches) 2
- (2) total depth (feet) 478
- (3) static water level (feet) 14 below top of ground.
- (4) casing GALV, 474, (material) (depth)

if telescope see back.
(size)

- (5) screen 4' 478 (length) (depth to top)

2 STAINLESS (size) (material)

- (6) pump 2 14 (HP) (yield gpm)

Elec (type power)

- (7) electric log NO (yes or no)

(organization running log)

- (8) how well bottom plugged 2-2" B.W.U.

DRILLERS REMARKS:


CODED

MAR 10 1970

MISS. RD. OF WATER COMM.

If well telescopes please sketch and show depths.

GROUND LEVEL

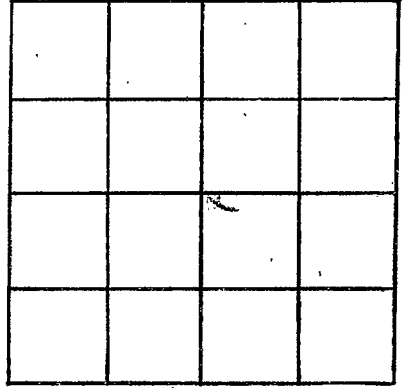

SECTION 13

Please indicate well location X.

ADDITIONAL INFORMATION

If more than one screen,
show locations of each on sketch.