

SMITH
G8
12-8-71

MISSISSIPPI
 BOARD OF WATER COMMISSIONERS
 416 North State Street
 Jackson, Mississippi 39201

WATER WELL DRILLERS LOG

Dec 8 1971 R. Wilkerson Drill, Sew. & Smith
 date well completed firm name county well located

LANDOWNER:	description of formations encountered	from	to
<u>Nova Hendon</u>			
<u>367 Main St.</u>	<u>Blue</u>	<u>42'</u>	<u>315'</u>
<u>Forest, Miss 39074</u>	<u>Rock - (Layers)</u>	<u>315'</u>	<u>410'</u>
(mailing address)	<u>water sand</u>	<u>410'</u>	<u>514'</u>

WELL LOCATION:
 sec. 14 T. 3 R. 9
8 miles S.W. of Raleigh
 (distance) (direction) (nearest town)

WELL PURPOSE: Home
 (home, irrigation, municipal, industrial)

- WELL COMPLETION DATA:
- (1) diameter (inches) 2"
 - (2) total depth (feet) 514'
 - (3) static water level (feet) 50' below top of ground.
 - (4) casing galv 514'
 (material) (depth)
 (size) if telescope see back.
 - (5) screen 10" 8'
 (length) (depth to top)
2" 8' Steel
 (size) (material)
 - (6) pump 2H
 (HP) (yield gpm)
elec
 (type power)
 - (7) electric log no
 (yes or no)
 - (organization running log)
 - (8) how well bottom plugged R.W. Dr


JAN 10 1972

PROD. DE. OF
 WATER CONTROL

DRILLERS REMARKS:

If well telescopes please sketch and show depths.

GROUND LEVEL

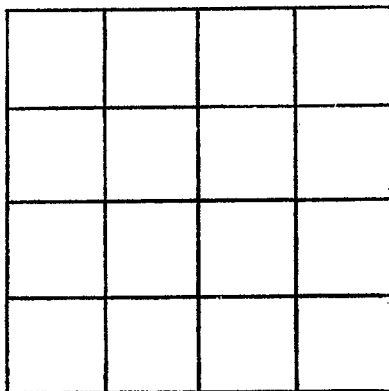

SECTION _____

Please indicate well location X.

ADDITIONAL INFORMATION

If more than one screen, show locations of each on sketch.