

SMITH
G9
1-4-72

MISSISSIPPI
BOARD OF WATER COMMISSIONERS
416 North State Street
Jackson, Mississippi 39201

WATER WELL DRILLERS LOG

CODED

1/4 1972 J.R. Parker water well Smith
date well completed firm name county well located

LANDOWNER: J.M. Coleman
Raleigh Miss.
(mailing address)

description of formations encountered	from	to
Red clay	0	20
Yellow chalk	20	35
Sand	35	60
Water Sand	60	80

WELL LOCATION:
sec 31 T 3 N R 8 E
2 miles N/E of Raleigh
(distance) (direction) (nearest town)

WELL PURPOSE: Home
(home, irrigation, municipal, industrial)

- WELL COMPLETION DATA:
- (1) diameter (inches) 2
 - (2) total depth (feet) 80
 - (3) static water level (feet) 60 ^{below} top of ground.
 - (4) casing PVC, 75 (material), (depth)
(size) if telescope see back.
 - (5) screen 5 ft, 80 (length), (depth to top)
2 in, PVC (size), (material)
 - (6) pump 3/4 (HP), 6 (yield gpm)
Jet (type power)
 - (7) electric log (yes or no)
(organization running log)
 - (8) how well bottom plugged Chalk

CODED

JAN 14 1972


MISS. Bd. of WATER COMMISSIONERS

DRILLERS REMARKS:

If well telescopes please sketch and show depths.

GROUND LEVEL

8 E

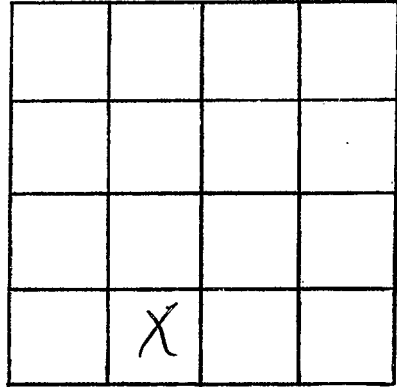

3 N

SECTION 32

Please indicate well location X.

ADDITIONAL INFORMATION

go to colored school
pass is front of
house on right

If more than one screen,
show locations of each on sketch.