

MISSISSIPPI DEPARTMENT OF NATURAL RESOURCES
Bureau of Land and Water Resources

Southport Mall
P.O. Box 10631

Jackson, Mississippi 39209

WATER WELL DRILLERS LOG

CODED

G 14
Smith
9-16-83

Griner Drilling Service, Inc.

Smith

date well completed

firm name

county well located

9-16-83

LANDOWNER:	description of formations encountered	from	to
Exeter Drilling 1444 Elk Place Suite 1502 New Orleans, La. 70112 (mailing address)	clay, rocks, sand	0	500
	sand	500	546
WELL LOCATION: 700' S + 1911' W of sec. 33 T 3 N R 8 E NE/4 cor 1/4 miles Raleigh of Hazelton (direction) of (nearest town) Wells			
WELL PURPOSE: oil field supply (home, irrigation, municipal, industrial)			
WELL COMPLETION DATA:			
(1) diameter (inches) 3"			
(2) total depth (feet) 546'			
(3) static water level (feet) 80' below top of ground.			
(4) casing steel 546' (material) (depth) 3" (size) if telescope see back.			
(5) screen 42' 504' (length) (depth to top) 3" perforated (size) (material)			
(6) pump - 80-90 (HP) (yield gpm) AC (type power)			
(7) electric log - (yes or no) (organization running log)			
(8) how well bottom plugged - orange peel			
DRILLERS REMARKS:			

CODED


DEPT. OF NATURAL RESOURCES
BUREAU OF LAND & WATER RESOURCES

OCT 3 1983

RECEIVED

If well telescopes please sketch and show depths.

GROUND LEVEL

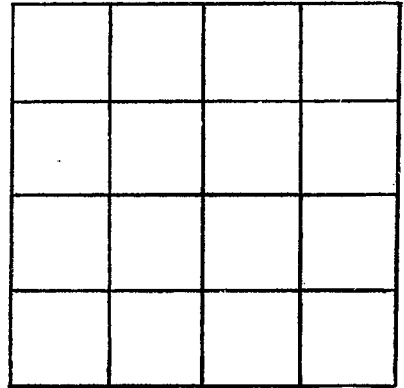

SECTION _____

Please indicate well location X.

ADDITIONAL INFORMATION

If more than one screen,
show locations of each on sketch.