

MISSISSIPPI DEPARTMENT OF NATURAL RESOURCES

Bureau of Land and Water Resources

Southport Mall

P.O. Box 10631

Jackson, Mississippi 39209

WATER WELL DRILLERS LOG

G15
SMITH
5-9-84

CODED

Griner Drilling Service, Inc.

Smith

5-9-84 date well completed

Griner Drilling Service, Inc. firm name

Smith county well located

LANDOWNER:	description of formations encountered	from	to
Memoran Exploration P.O. Box 6800 Metairie, La. 70009 (mailing address)			
WELL LOCATION: 1050' S 4 2100' E sec. 10 T 30 N R 8 E of east of Raleigh (distance) miles (direction) (nearest town)	sand	376	482
WELL PURPOSE: oil field supply (home, irrigation, municipal, industrial)	clay	482	483
WELL COMPLETION DATA:	No. 1 Percy A. Thornton		
(1) diameter (inches) 3"			
(2) total depth (feet) 483'			
(3) static water level (feet) 100' below top of ground.			
(4) casing steel 483' (material) (depth)			
3" (size) if telescope see back.			
(5) screen 42' 441' (length) (depth to top)			
3" perforated (size) (material)			
(6) pump - 75 (HP) (yield gpm)			
AC (type power)			
(7) electric log (yes or no)			
(organization running log)			
(8) how well bottom plugged orange peel			
DRILLERS REMARKS:			


DEPT. OF NATURAL RESOURCES
BUREAU OF LAND & WATER RESOURCES

MAY 21 1984

RECEIVED

If well telescopes please
sketch and show depths.

GROUND LEVEL

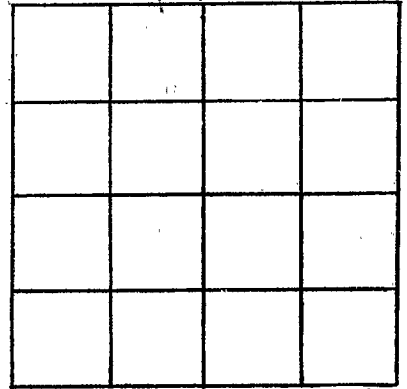

SECTION _____

Please indicate well location X.

ADDITIONAL INFORMATION

If more than one screen,
show locations of each on sketch.