

MISSISSIPPI DEPARTMENT OF NATURAL RESOURCES

Bureau of Land and Water Resources

CODED

Southport Mall

P.O. Box 10631

CODED

Jackson, Mississippi 39209

WATER WELL DRILLERS LOG

SMITH  
G 19  
4-10-86

Griner Drilling Service, Inc.

Smith

4-10-86 date well completed

Griner Drilling Service, Inc. firm name

Smith county well located

LANDOWNER:

Cities Service Oil & Gas  
620 North Street  
P.O. Box 12026  
Jackson, MS. 39211  
(mailing address)

description of formations encountered

from

to

chalk, rocks

0 420

sand

420 567

WELL LOCATION: 750'S x 300'E

sec. 10 T. 3 N. R. 8 E of No. 1 M.O. Bowling Field

CODED

Thornton Mes. Creek of (distance) (direction) (nearest town)

WELL PURPOSE: oilfield rig (home, irrigation, municipal, industrial) supply

WELL COMPLETION DATA:

- (1) diameter (inches) 3"
- (2) total depth (feet) 567'
- (3) static water level (feet) 150' below top of ground.
- (4) casing steel, 567' (material) (depth) 3" (size) If telescope see back.
- (5) screen 63', 504' (length) (depth to top) 3", perforated (size) (material)
- (6) pump (HP) 75 (yield gpm) (type power) AC
- (7) electric log (yes or no)

504  
5/10  
5

APR 15 1986  
Department of Natural Resources  
Bureau of Land & Water Resources


(organization running log)

(8) how well bottom plugged orange pee

DRILLERS REMARKS:

If well telescopes please sketch and show depths.

GROUND LEVEL

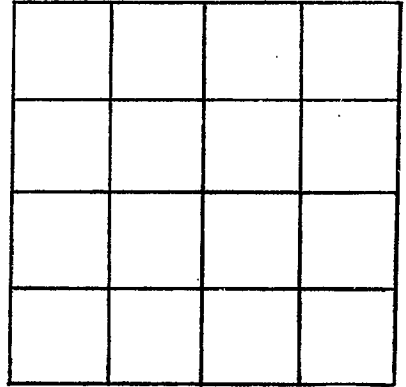

SECTION \_\_\_\_\_

Please indicate well location X.

ADDITIONAL INFORMATION

If more than one screen, show locations of each on sketch.