

MISSISSIPPI DEPARTMENT OF NATURAL RESOURCES

Bureau of Land and Water Resources

Southport Mall

P.O. Box 10631

Jackson, Mississippi 39209

WATER WELL DRILLERS LOG

Griner Drilling Service, Inc.

CODED
Smith

SMITH
G-21

10-13-88
date well completed

Griner Drilling Service, Inc.
firm name

county well located

LANDOWNER:
Chesley Pruet
Drilling Co.
P.O. Box 324
Laurel, MS 39440

description of formations encountered	from	to
	clay, rocks	0
SAND	546	609
clay, sand	609	620

WELL LOCATION: 650' N + 800' W
sec 34 T 30 S R 80 E S 10
Pruet Production Raleigh
distance miles (direction) (nearest town)

WELL PURPOSE: oil field
home, irrigation, municipal, industrial

WELL COMPLETION DATA:

- (1) diameter (inches) 3"
- (2) total depth (feet) 620'
- (3) static water level (feet) 120' ^{below} top of ground
- (4) casing steel 546' 609' (material) (depth)
- (5) screen 3" 63' 185' (size) (length) (depth to top)
- (6) pump AC 60 (type power) (yield gpm)
- (7) electric log (yes or no) no
- (8) how well bottom plugged orange peel

RECEIVED


NOV 14 1988

Department of Natural Resources
Bureau of Land & Water Resources

DRILLERS REMARKS:

If well telescopes please sketch and show depths.

GROUND LEVEL

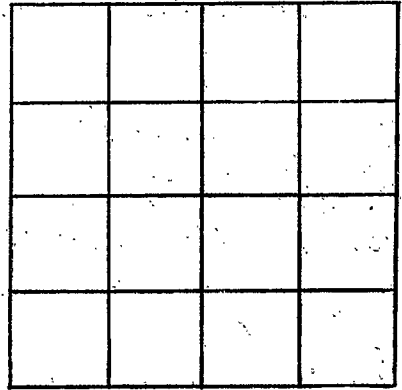

SECTION _____

Please indicate well location X.

ADDITIONAL INFORMATION

If more than one screen, show locations of each on sketch.