

Smith
G 2000
2-15-77

MISSISSIPPI
BOARD OF WATER COMMISSIONERS
416 North State Street
Jackson, Mississippi 39201

WATER WELL DRILLERS LOG

2-15-77 date well completed
Adcock water well ser. firm name
Smith county well located


LANDOWNER: Nathan
Shernton
Raleigh, Miss.
(mailing address)

WELL LOCATION:
sec. 15 T-3 N R-8 E
6 miles N. E. of Raleigh
(distance) (direction) (nearest town)

WELL PURPOSE: Homouse
(home, irrigation, municipal, industrial)

- WELL COMPLETION DATA:
- (1) diameter (inches) 2
 - (2) total depth (feet) 240
 - (3) static water level (feet) 105 below above top of ground.
 - (4) casing 2" (material) 126 (depth)
 - 2 (size) if telescope see back.
 - (5) screen (length) (depth to top)
 - (size) (material)
 - (6) pump 1 1/2 (HP) (yield gpm)
 - electric (type power)
 - (7) electric log no (yes or no)
 - (organization running log)
 - (8) how well bottom plugged open

description of formations encountered	from to	
Clay	0	5
Sand	5	50
Rock & Clay	50	55
Clay	55	100
Rock	100	110
Shell & Sand	110	120
Rock & Shell	120	130
Rock & Shell	130	140
clay	140	157
Clay & sand	157	200
Rock	200	205
Clay	205	210
Sand & Clay	210	240

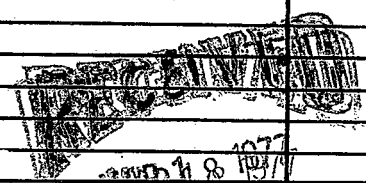


DRILLERS REMARKS:

MISS. BD. OF WATER COMMISSIONERS

If well telescopes please sketch and show depths.

GROUND LEVEL

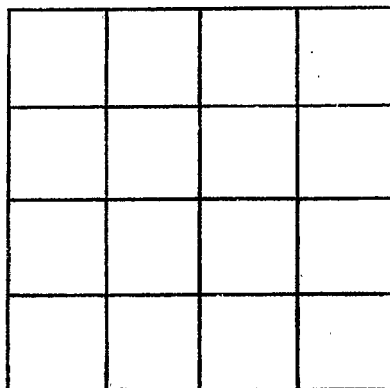

SECTION _____

Please indicate well location X.

ADDITIONAL INFORMATION

If more than one screen, show locations of each on sketch.