

**MISSISSIPPI DEPARTMENT OF NATURAL RESOURCES**  
**Bureau of Land and Water Resources**  
 Southport Mall  
 P.O. Box 10631  
 Jackson, Mississippi 39209  
**WATER WELL DRILLERS LOG**

G 2002  
Smith

2-21 1985 Ray West Dalg Smith  
 date well completed firm name county well located

LANDOWNER:	description of formations encountered	from	to
<u>Raleigh Forest Prod.</u>	<u>SANDY CLAY</u>	<u>0</u>	<u>4</u>
<u>Raleigh MS</u> (mailing address)	<u>SAND</u>	<u>4</u>	<u>120</u>

**WELL LOCATION:**  
 sec. 18 T 3 N R 8 E  
4 miles N of Raleigh  
 (distance) (direction) (nearest town)

**WELL PURPOSE:** Saw Mill  
 (home, irrigation, municipal, industrial)

- WELL COMPLETION DATA:**
- diameter (inches) 4"
  - total depth (feet) 120'
  - static water level (feet) 98' below top of ground.
  - casing PVC, 110'  
 (material) (depth)  
 (size) if telescope see back.
  - screen 10', 110'  
 (length) (depth to top)  
4", PVC  
 (size) (material)
  - pump 1/2, 10  
 (HP) (yield gpm)  
REA  
 (type power)
  - electric log no  
 (yes or no)  
 (organization running log)
  - how well bottom plugged with concrete

**RECEIVED**


MAR 6 - 1985

**DRILLERS REMARKS:**

Department of Natural Resources  
 Bureau of Land & Water Resources

If well telescopes please sketch and show depths.

GROUND LEVEL

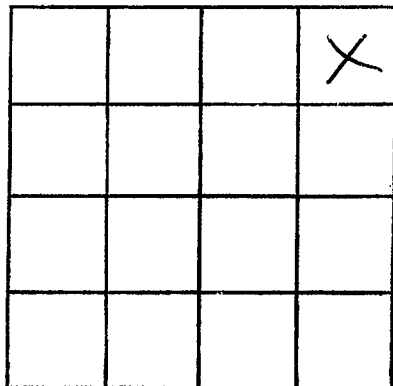

SECTION 18

Please indicate well location X.

ADDITIONAL INFORMATION

If more than one screen,  
show locations of each on sketch.