

3 H 2
3-26-63

WATER WELL DRILLERS LOG

Smith

Date: 3-26, 1963, Driller: Trust Delg. Inc. County: Scott
(Name)

(1) Owner of Land: Alvin McNeil
(Name)
Rt - Louin, Miss.
(Address)

(2) Location: SW 1/4, SW 1/4, Sec. 8 T31N R9E
2 miles South of Pineville
(distance) (direction) (Nearest Town)

(3) Topography: _____
(Hilly) (Flat) (Level)

(4) Purpose of Well: Chicken Farms
(Domestic Irrigation
Municipal, Industrial, Other)

Description & Color of Materials Sand, Clay, Red Clay, Shell, etc.	Thick- ness Feet	Depth Feet
Red Clay	0	12
Clay + Shale Sand		32
Clay		52
Clay + Mdy sand		62
Blue Clay		142
Clay		242
Shale		337
Shale + Lime Rock		377
Shale		458
Fine Sand		475
Soft Shale		498
Fine Sand		508
Mdy Sand		512
Fine Sand		578
Mdy Sand + Clay		598
Fine Sand		591

Information upon completion of well:

(1) Diameter 2" inches.

(2) Total Depth 590 feet.

(3) Water Level 100 feet below top of ground.

(4) Cased to 575, Size 2"

(5) Screen: Size 2", Length 15ft.


(6) Were any formations sealed against pollution?
_____ yes, X no.

after alteration
N sp Cond
H P 380

If YES depth of formation _____

Why air coming
3 ft.

Drillers Remarks: No stain
Soft 66.9

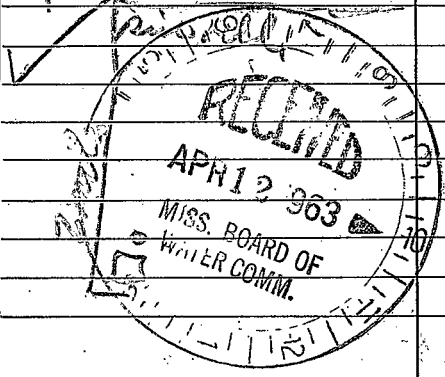

(Use Back Side)

Well No.

