

24

WATER WELL DRILLERS LOG

Date: 3/20, 1964, Driller: Trust Drilling County Scott
 (Name)


(1) Owner of Land: J. C. Hannon
 (Name)
Rt 2 Raleigh, Miss
 (Address)
 (2) Location: 1/4, 1/4, Sec. 17 T R
3 miles South of Pineville
 (distance) (direction) (Nearest Town)
 (3) Topography: on Hwy 501
 (Hilly) (Flat) (Level)
 (4) Purpose of Well: Chicken
 (Domestic Irrigation, Municipal, Industrial, Other)

Description & Color of Materials Sand, Clay, Red Clay, Shell, etc.	Thickness Feet	Depth Feet
<u>Red Clay</u>		<u>10</u>
<u>Blue clay</u>		<u>80</u>
<u>Blue clay</u>		<u>307</u>
<u>Blue sh. + sh. lime Rock</u>		<u>430</u>
<u>Shale + silt</u>		<u>471</u>
<u>Shale</u>		<u>492</u>
<u>Shale + sh. silt</u>		<u>533</u>
<u>Shale + sand</u>		<u>554</u>
<u>Sand + sh. shale</u>		<u>582</u>

Information upon completion of well:

(1) Diameter 2 inches.
 (2) Total Depth 582 feet.
 (3) Water Level 65' feet below top of ground.
 (4) Cased to 567, Size 2"
 (5) Screen: Size 2, Length 15.
 (6) Were any formations sealed against pollution?
 _____ yes, X no.

If YES depth of formation _____
 Why _____
 Drillers Remarks: _____

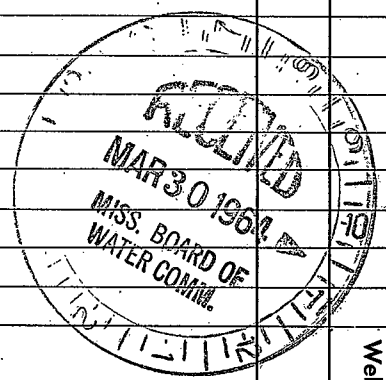

Well No.

(Use Back Side)

