

Smith
H9
3-13-69

MISSISSIPPI
BOARD OF WATER COMMISSIONERS CODED
416 North State Street
Jackson, Mississippi 39201
WATER WELL DRILLERS LOG

3-13 date well completed 169 W.K. Barnes Water Wells firm name Smith county well located

LANDOWNER: J. W. Sullivan
Sylverena Miss.
(mailing address)

description of formations encountered	from	to
Red Clay	0	12
yellow clay	12	26
Black clay	26	54
Rock	54	60
Blue clay	60	130
Fine Blue Sand	130	151

WELL LOCATION:
sec. 34 T. 10 N. R. 9 E
S W
1/4 miles north of Sylverena
(distance) (direction) (nearest town)

WELL PURPOSE: Home
(home, irrigation, municipal, industrial)


- WELL COMPLETION DATA:
- (1) diameter (inches) 2
 - (2) total depth (feet) 151
 - (3) static water level (feet) 74 below top of ground.
 - (4) casing Galv. (material), (depth)
1 1/4 (size) if telescope see back.
 - (5) screen 5 (length), (depth to top)
1/2 in. Stainless (size) (material)
 - (6) pump Galv. 3 (HP) (yield gpm)
Elec. (type power)
 - (7) electric log (yes or no)
 - (organization running log)
 - (8) how well bottom plugged with material

DRILLERS REMARKS:

APR 2 - 1969
WATER

If well telescopes please sketch and show depths.

GROUND LEVEL

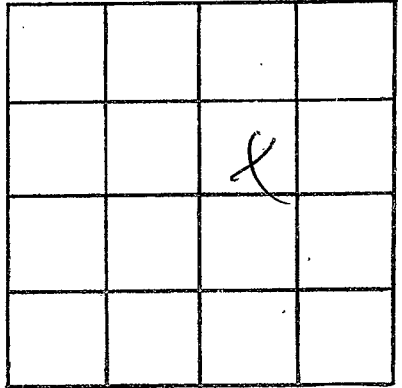

SECTION 34

Please indicate well location X.

ADDITIONAL INFORMATION

If more than one screen, show locations of each on sketch.