

ELOG# 164

Smith
H-11
7-20-71

MISSISSIPPI
BOARD OF WATER COMMISSIONERS
416 North State Street
Jackson, Mississippi 39201

WATER WELL DRILLERS LOG

CODED

7-20 date well completed 19 70 Barneo Drilling firm name Smith county well located

LANDOWNER:	description of formations encountered	from	to
Reneville			
Water Assoc. TH #1	Top Soil	0	30
Pineville, Miss	Sand	30	40
(mailing address)	Blue Clay	40	370
	Sand	370	380
WELL LOCATION:	Dark Shell	380	460
sec. 5 T. 3 N. R. 9 E	Sand & Shell	460	520
2 miles S of Pineville	Fine Sand	520	560
(distance) (direction) (nearest town)	Dark Green		
WELL PURPOSE: municipal	Shell	560	640
(home, irrigation, municipal, industrial)	Sandy Shell	640	670
	Rock	670	694
WELL COMPLETION DATA:	Shell	694	702
(1) diameter (inches) 8"	Rock	702	707
(2) total depth (feet) 946	Shell	707	720
(3) static water level (feet) 187 below top of ground.	Sand	720	800
(4) casing Steel, 890, (material), (depth)	Shell	800	810
8x6 (size) if telescope see back.	Good Sand	810	950
(5) screen 60, 890 (length), (depth to top)	Shell	950	970
4" (size), SS (material)	Sand Sand	970	1030
(6) pump 25 (HP), 200 (yield gpm)	Shell	1030	1136
Elect (type power)			
(7) electric log yes (yes/or no)			
AGS (organization running log)			
(8) how well bottom plugged BWU			

CODED

Nov 9 1970
Miss. Board of
Water Comm.

DRILLERS REMARKS:

(X)


If well telescopes please sketch and show depths.

GROUND LEVEL

840' of 8" casing →

50' of 6" lap pipe →

60' of screen
6" →

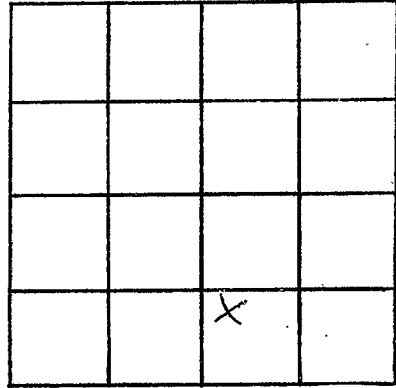

SECTION 5

Please indicate well location X.

ADDITIONAL INFORMATION

This Well is
Gravel Wall Well

If more than one screen, show locations of each on sketch.