

SMITH  
H 12  
7-9-71

MISSISSIPPI  
BOARD OF WATER COMMISSIONERS  
416 North State Street  
Jackson, Mississippi 39201

**CODED**

WATER WELL DRILLERS LOG

Date 9 1971 W. M. Butler Smith  
 (date well completed) firm name county well located

LANDOWNER:

Lonestud Done

Sylvasena, Miss  
 (mailing address) At-

WELL LOCATION:

sec. 34 T. 3 S. R. 9 E. W. 5  
2 miles N of Sylvasena  
 (distance) (direction) (nearest town)

WELL PURPOSE:

Home  
 (home, irrigation, municipal, industrial)

WELL COMPLETION DATA:

- (1) diameter (inches) 2"
- (2) total depth (feet) 140'
- (3) static water level (feet) 70 below above top of ground.
- (4) casing galv. 25'  
 (material) (depth)  
2" if telescope see back.  
 (size)
- (5) screen 5' 85'  
 (length) (depth to top)  
2" (size) SS (material)
- (6) pump 2HP 60  
 (HP) (yield gpm)  
Electric  
 (type power)
- (7) electric log no  
 (yes or no)

description of formations encountered

from to

Clay & sand	0	10
Clay	10	30
Sand & Clay	30	50
Clay & P. granite	50	55
Sand	55	60
Clay & sand	60	80
S. sand	80	90
Sand, clay - granite	90	100
Clay & sand	100	130
Clay	130	140

**CODED**

III 16 1971

MISS. Bd. OF  
 WATER COMMISSIONERS


(organization running log)

(8) how well bottom plugged 2" BML

DRILLERS REMARKS:

If well telescopes please sketch and show depths.

GROUND LEVEL

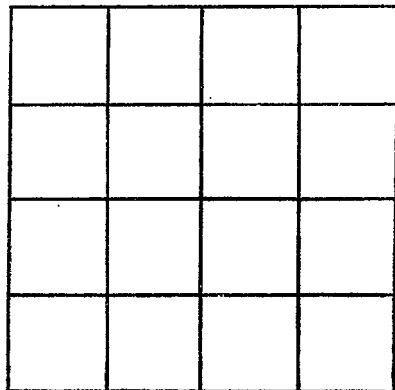

SECTION \_\_\_\_\_

Please indicate well location X.

ADDITIONAL INFORMATION

If more than one screen, show locations of each on sketch.