

Smith  
H13  
12-22-71

MISSISSIPPI  
BOARD OF WATER COMMISSIONERS  
416 North State Street  
Jackson, Mississippi 39201

WATER WELL DRILLERS LOG

**CODED**

Dec 22 1971 date well completed  
Wilkinson Drilling Serv firm name  
Shelby county well located

LANDOWNER: Mr. Jerry Smith  
Route  
Raleigh, Miss  
(mailing address)

description of formations encountered	from	to
yellow clay	0	15
Blue clay	15	105
Sandy y. Clay	105	190
Black clay	190	240
Green shale	240	305
Blue Clay	305	400
Sand. Fine	400	450
Coarse Sand	450	480

WELL LOCATION:  
sec. 9 T 3 N R 9 E S W  
5 miles S.E. of Pinville  
(distance) (direction) (nearest town)

WELL PURPOSE: Home  
(home, irrigation, municipal, industrial)

WELL COMPLETION DATA:

(1) diameter (inches) 2

(2) total depth (feet) 480

(3) static water level (feet) 35 below top of ground.

(4) casing 480 (material) (depth)

(5) screen 47 (length) (depth to top)  
2 (size) 8. Steel (material)

(6) pump 2 (HP) (yield gpm)  
Elec (type power)

(7) electric log no (yes or no)

(8) how well bottom plugged B.M.V.

**CODED**


JAN 13 1972

MISS. RD. OF  
WATER COMM.

DRILLERS REMARKS:

If well telescopes please sketch and show depths.

GROUND LEVEL

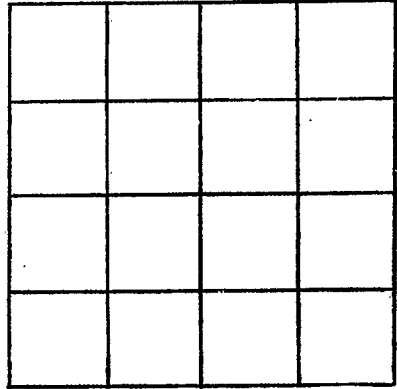

SECTION \_\_\_\_\_

Please indicate well location X.

ADDITIONAL INFORMATION

If more than one screen,  
show locations of each on sketch.