

SMITH

H-15

7/28/80

MISSISSIPPI BOARD OF WATER COMMISSIONERS
416 North State Street
Jackson, Mississippi 39201

CODED

WATER WELL DRILLERS LOG

Spiner Drilling Service, Inc.

Smith

date well completed

firm name

county well located

LANDOWNER:
Hughes and Hughes
1111 Capital Towers
Jackson, Ms 39201
(mailing address)

description of formations encountered

from to

<i>sand + gravel</i>	<i>0</i>	<i>245</i>
<i>clay + gravel</i>	<i>245</i>	<i>287</i>
<i>sand</i>	<i>287</i>	<i>300</i>
<i>streaked</i>	<i>300</i>	<i>370</i>
<i>sand</i>	<i>370</i>	<i>399</i>
<i>streaked</i>	<i>399</i>	<i>567</i>
<i>sand</i>	<i>567</i>	<i>630</i>
<i>chalk</i>	<i>630</i>	<i>651</i>

WELL LOCATION: *1500' N + 1325' W*

No. 1 David Wilson
23-30 of *9* SE/4
23-10 Magee-Mize
(distance) (direction) (nearest town)

WELL PURPOSE: *outlet supply*
(home, irrigation, municipal, industrial)

WELL COMPLETION DATA:

- (1) diameter (inches) *3"*
- (2) total depth (feet) *651'*
- (3) static water level (feet) *175'* ^{below} _{above} top of ground.
- (4) casing *steel* *630'*
(material) (depth)
- 3"*
(size) if telescope see back.
- (5) screen *42'* *588'*
(length) (depth to top)
- 3"* *perforated*
(size) (material)
- (6) pump *—* *65*
(HP) (yield gpm)
- ac*
(type power)
- (7) electric log *—*
(yes or no)

(organization running log)

(8) how well bottom plugged *orange*
peel

DRILLERS REMARKS:


DEPT. OF NATURAL RESOURCES
BUREAU OF LAND & WATER RESOURCES

AUG 6 1980

RECEIVED

If well telescopes please sketch and show depths.

GROUND LEVEL

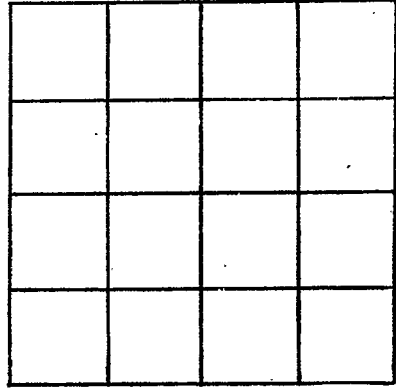

SECTION _____

Please indicate well location X.

ADDITIONAL INFORMATION

If more than one screen,
show locations of each on sketch.